

T-5174

286  
FROM

**RECEIVED**


DEC 13 1982

**WATER RESOURCES DEPT.  
SALEM, OREGON**

MSKENZIE

HIGHWAY

THE DALLAS-CALIFORNIA HIGHWAY

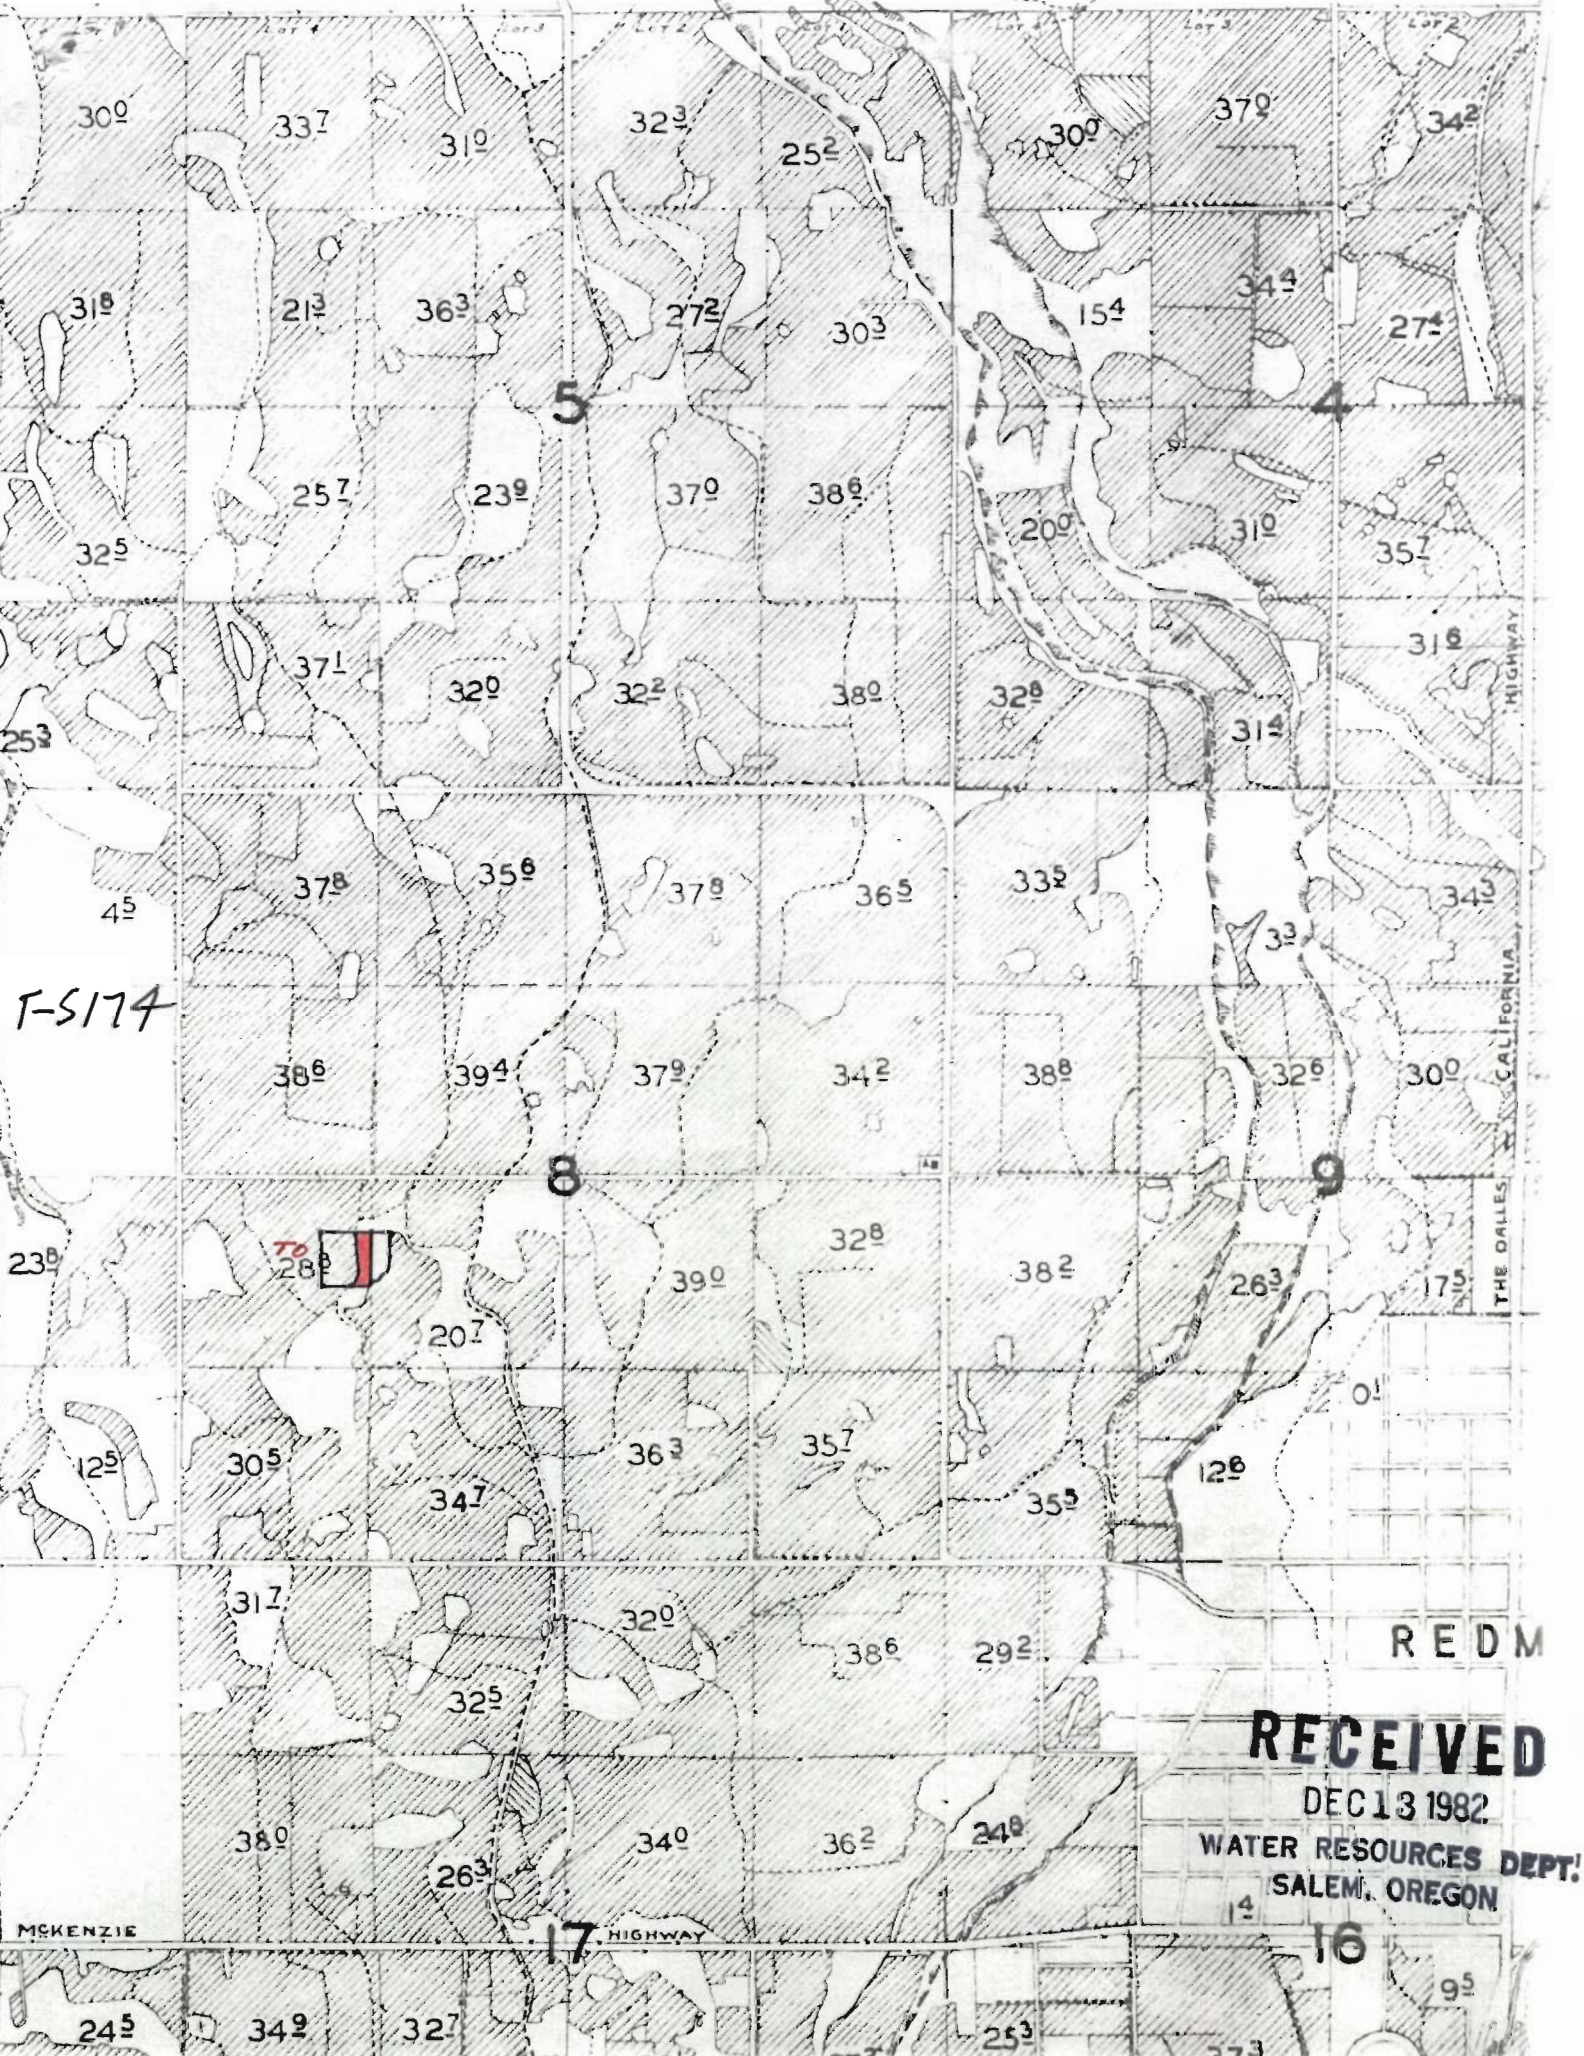

300 337 310 323 252 300 370 342  
310 213 363 272 303 154 343 274  
257 239 370 386 200 310 357  
325 371 320 322 380 320 314 310  
45 378 356 378 365 332 343  
386 394 379 342 388 326 300  
230 28 207 390 328 382 263 175  
125 305 347 363 357 353 128 0  
317 320 386 292 240  
380 263 340 362 240  
245 342 327 253 73 95

T-5174

28

RECEIVED

DEC 13 1982

WATER RESOURCES DEPT.  
SALEM, OREGON

MCKENZIE

17 HIGHWAY

THE DALLES CALIFORNIA HIGHWAY

REDM

16