


T. 13S., R. 31E., W.M.

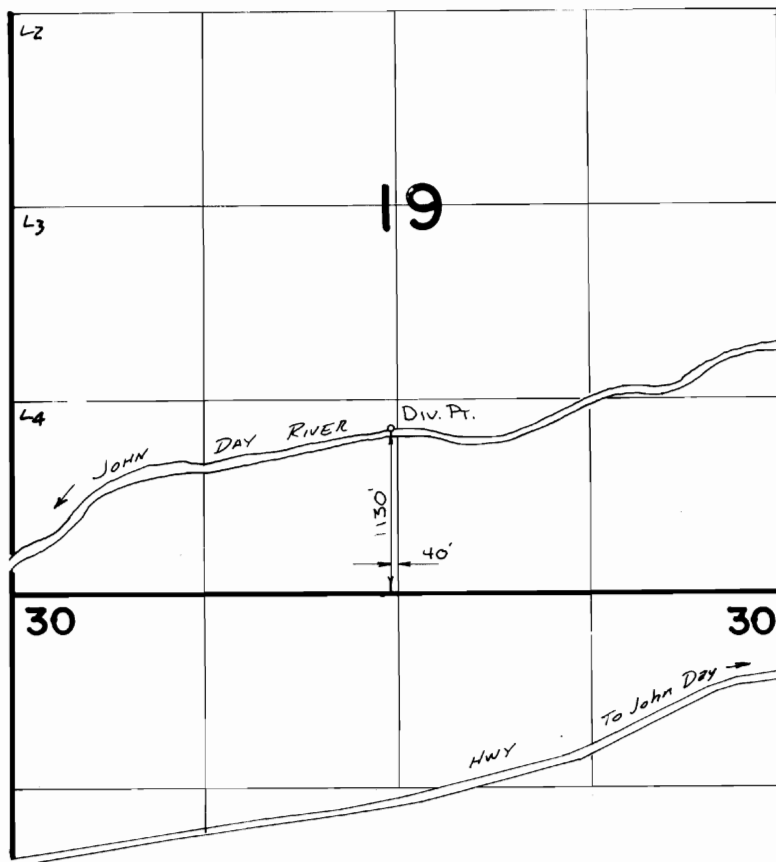

SCALE 1" = 1320'

FINAL PROOF SURVEY
UNDER

TRANSFER 5180

IN NAME OF

JIM & MARILYN DEROY

Surveyed 4-7 1984, by V.L. Church