


T. 7S., R. 38E., W. M.

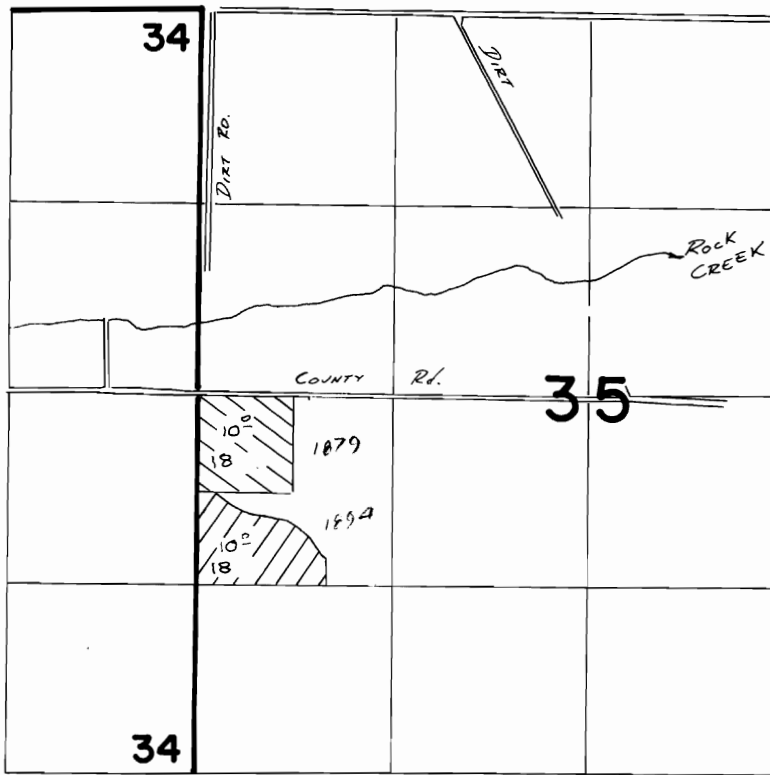

SCALE 1" = 1320'

FINAL PROOF SURVEY
UNDER

TRANSFER 5181
IN NAME OF

.....**FRANCIS B. ZIMMERMAN**.....

Surveyed 6-3 1987, by V.L. Church