

T-5184


T-3799

T-3799
3⁰-ac OUT
(Carpenter)

RECEIVED

SEP 28 1977


WATER RESOURCES DEPT
SALEM, OREGON

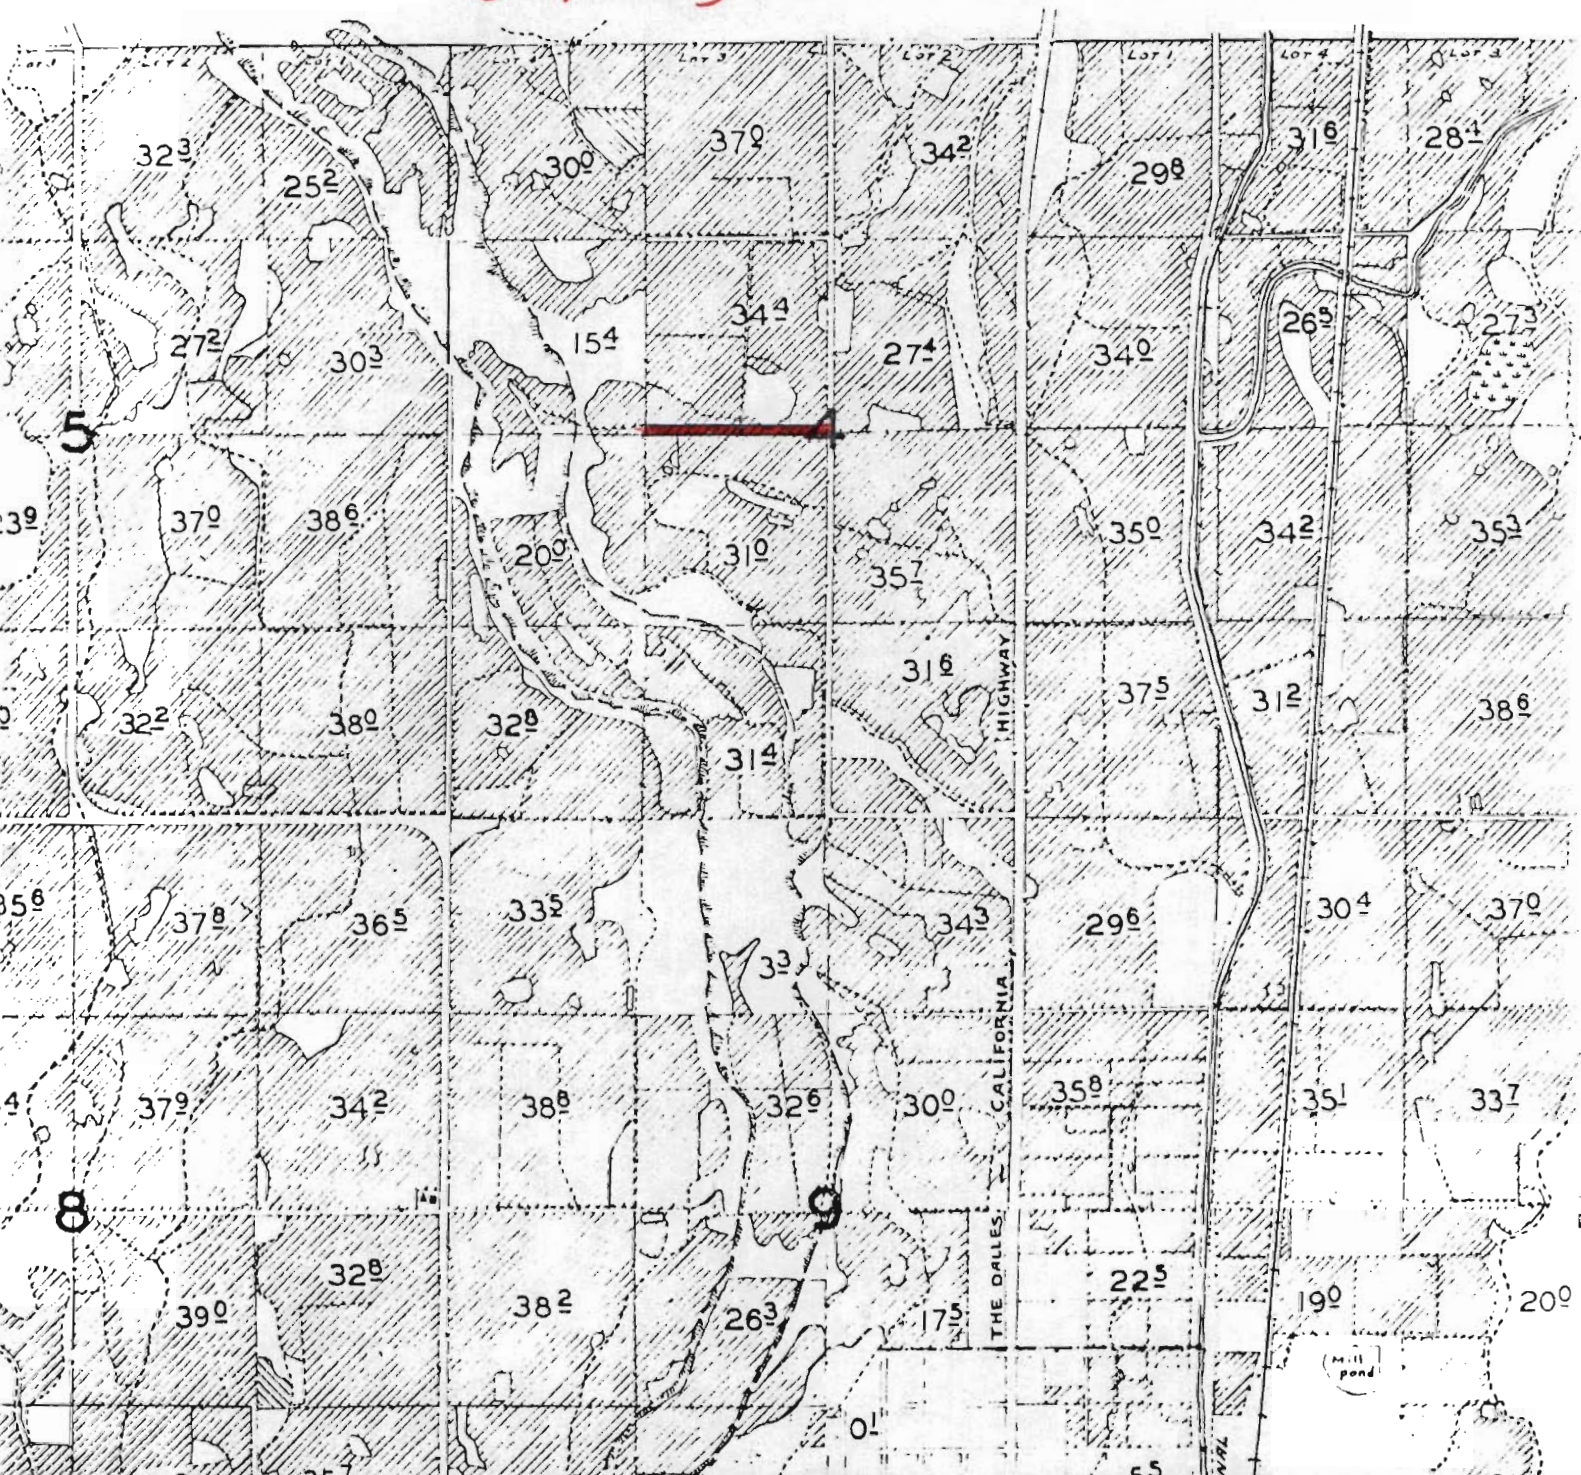

T. 17 S., R. 12 E. W.M.

Scale 4" = Approx. 1 mile

T-5184

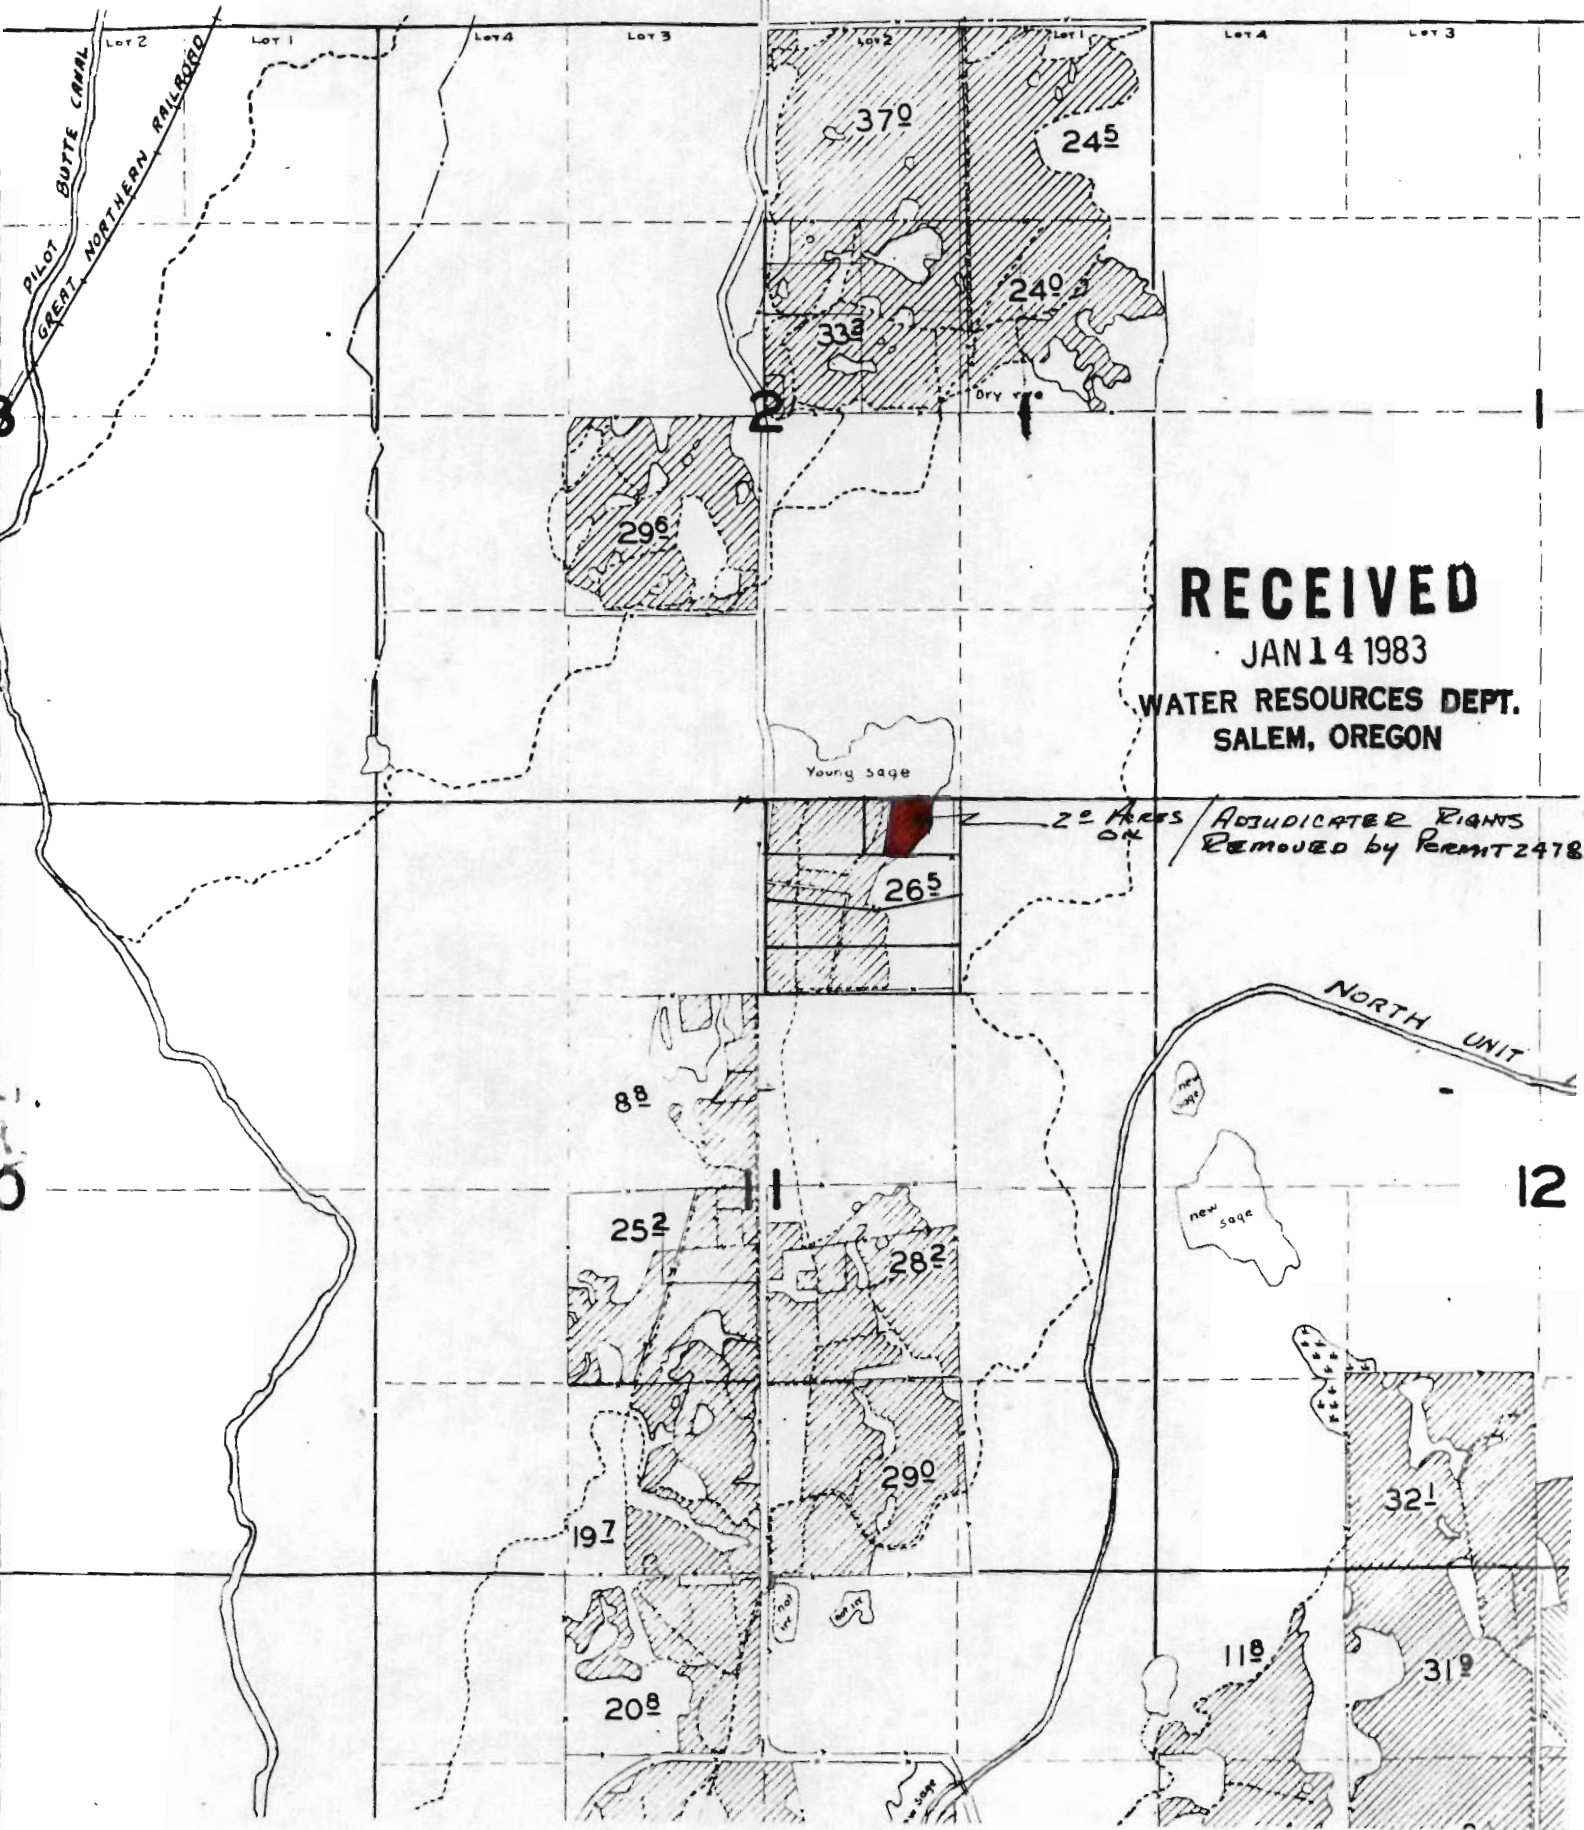

RECEIVED

JAN 14 1983

WATER RESOURCES DEPT.
SALEM, OREGON

20 ACRES ON ADJUDICATED RIGHTS
REMOVED BY PERMIT 2478

12


T. 17 S., R. 12. E. U.M.
Scale 4" = 1 mile

10

F-5189

RECEIVED

JAN 14 1983
WATER RESOURCES DEPT.
SALEM, OREGON

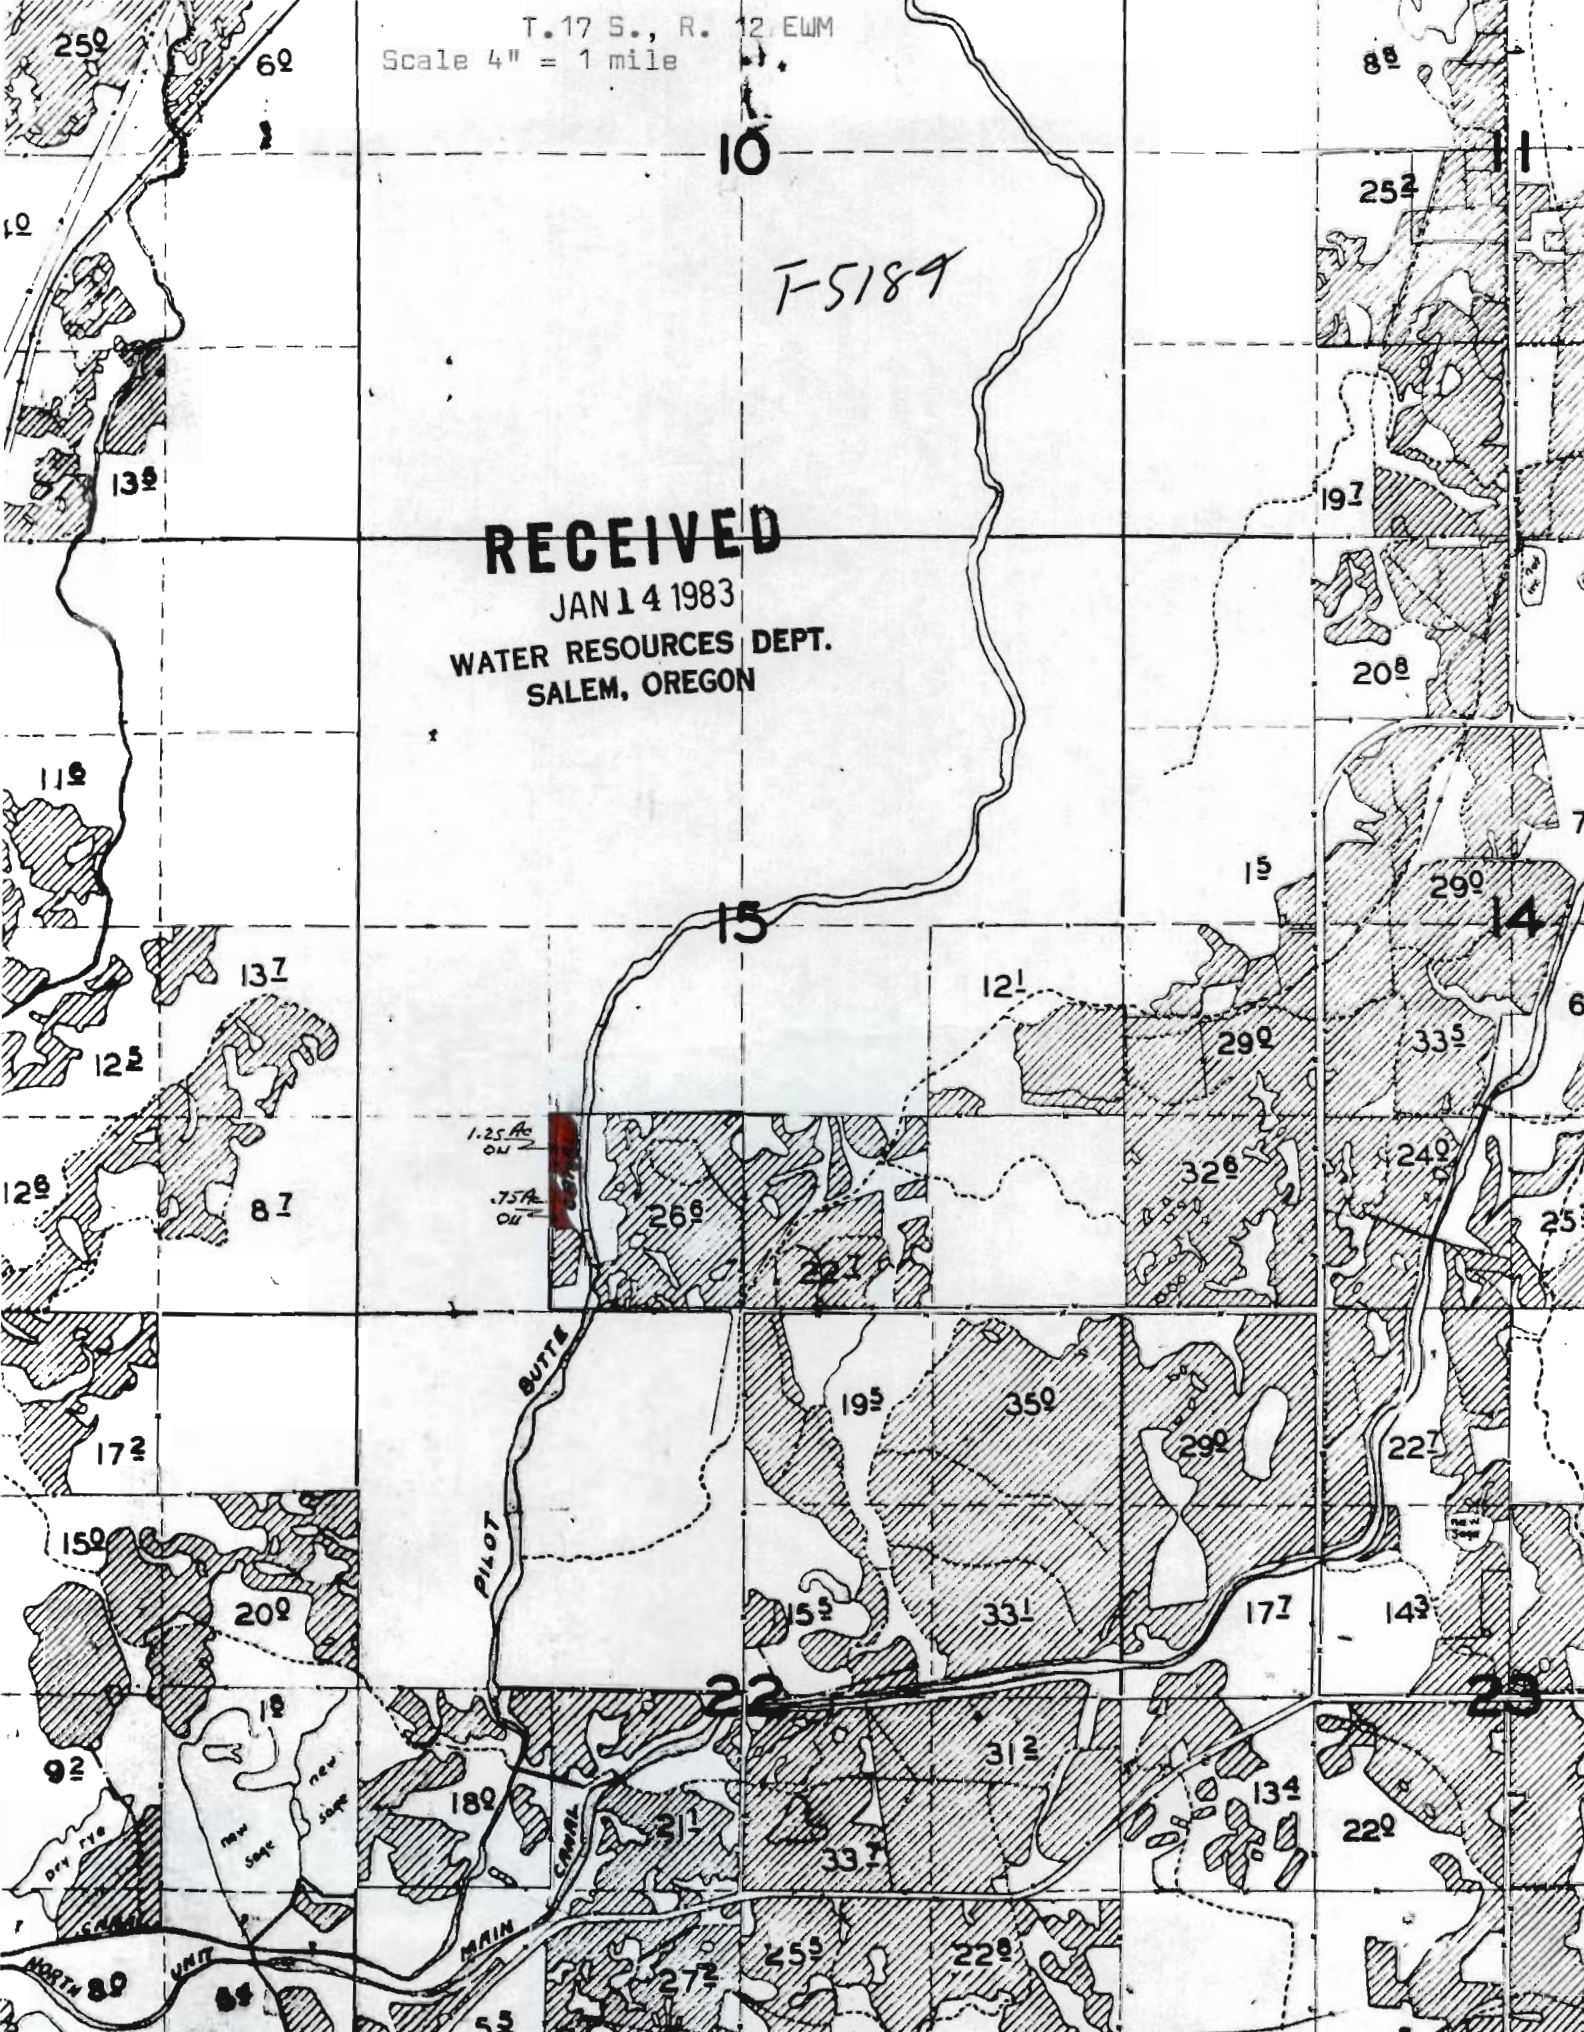

TOWNSHIP 15 SOUTH, RANGE 13

RANGE 13

SCALE: 4" = Approx. 1 mile

RECEIVED

JAN 19 1983

WATER RESOURCES DEPT.
SALEM, OREGON

