


T. 5 S., R. 12 E., W. M.

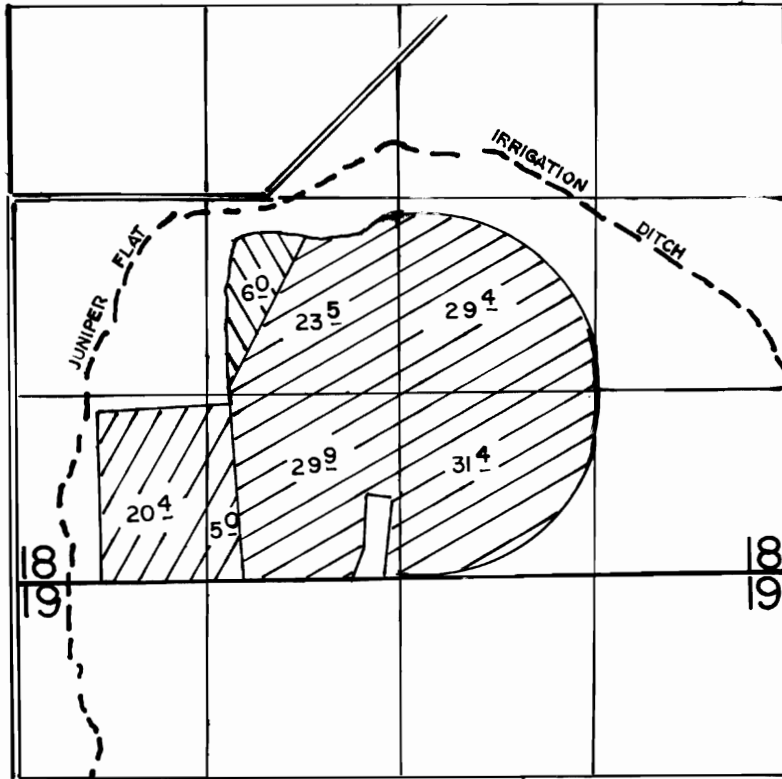

Div Pts. Clear Cr. 610'S & 2380' W From The E 1/4 Cor. Sec 10, T 5 S, R 9 E, Frog Cr. 200'S & 900' W From The NE Cor. Sec 34, Clear Lake Res 1389.6 S & 480.27 W From E 1/4 Cor Sec 32, Both T 4 S, R 9 E



Transfer No 5194

Transfer No 5759

Permit No 47767

SCALE: 1" = 1320'

FINAL PROOF SURVEY

UNDER

TRANSFERS NO 5194
5759

Application No. 64795... Permit No. 47767.....

IN NAME OF

JUNIPER FLAT DISTRICT IMPROVEMENT CO.

Surveyed APRIL 14, 1989., by K.K.KEMP.....