


T. 35 S., R. 4 W., W. M.

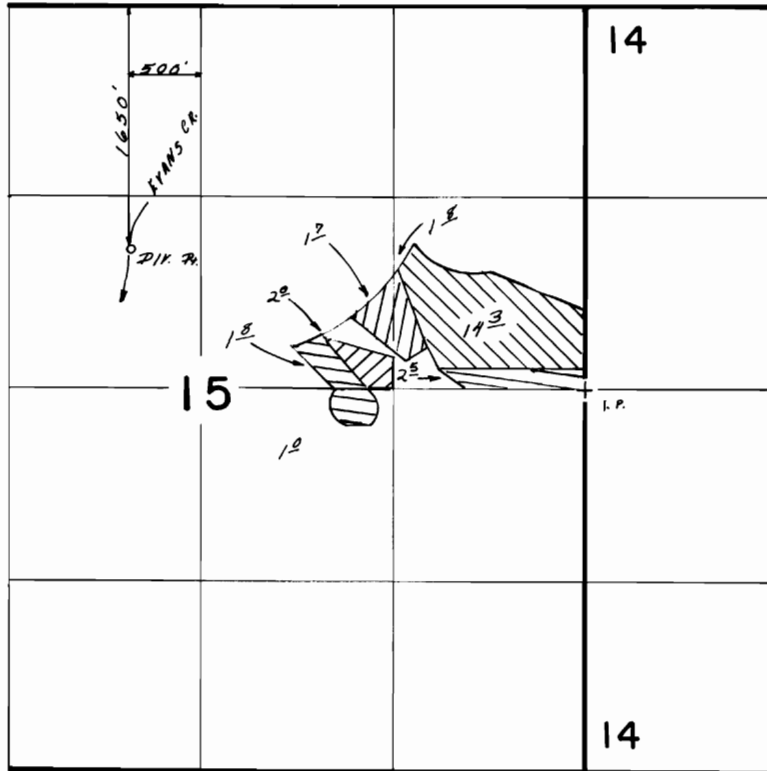

-  T-5195
-  T-5196
-  T-5197
-  T-5214

Scale: 1" = 1320'

FINAL PROOF SURVEY UNDER

TRANSFERS NO. 5195, 5196, 5197, 5214, 4384

Application No. Permit No.

IN NAME OF

JAMES H. & LOTTIE L. MARTIN

Surveyed F.E.B., I.I., 1986, by B.S., JAMES