


T. 35 S., R. 4 W., W. M.

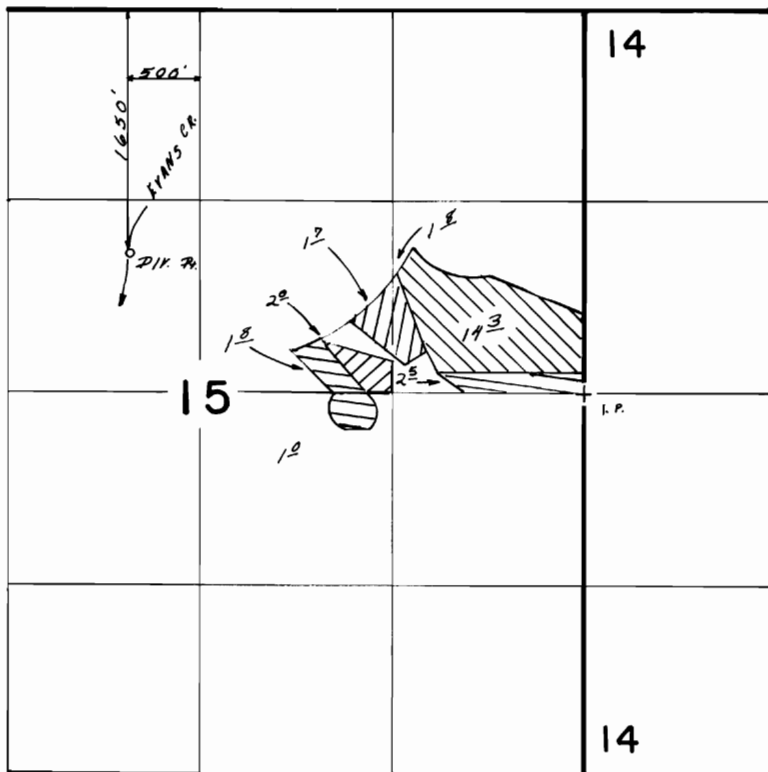

-  T-5195
-  T-5196
-  T-5197
-  T-5214

Scale: 1" = 1320'

**FINAL PROOF SURVEY**  
UNDER

**TRANSFERS NO. 5195, 5196, 5197, 5214, 4384**

Application No. .... Permit No. ....

IN NAME OF

**JAMES H. & LOTTIE L. MARTIN**

Surveyed F.E.B., I.I., 1986, by B.S., JAMES