


T. 39S., R. 3W., W.M.

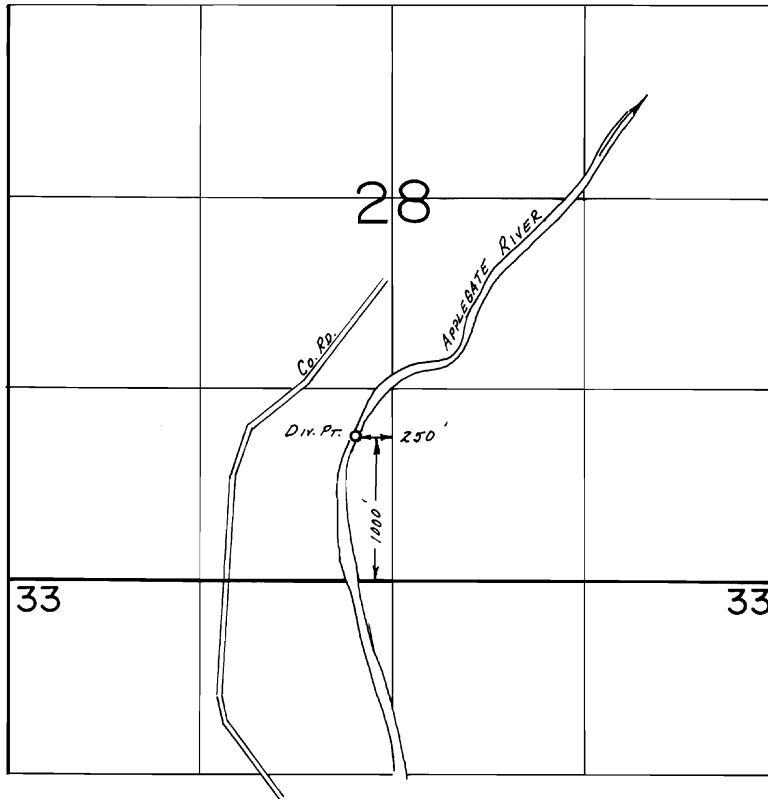

SCALE: 1" = 1320'

FINAL PROOF SURVEY
UNDER

Transfer No. 5200

IN NAME OF

..... BRUCE MORRELL

Surveyed July 9, 1985, by B.S. JAMES.....