


T. 9S., R. 40E., W. M.

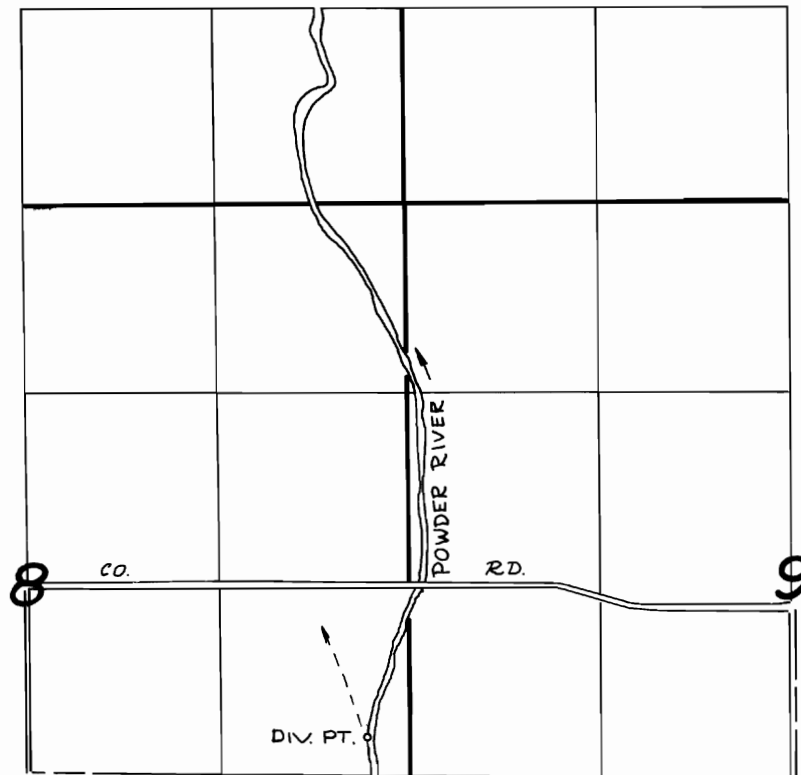

DIVERSION POINT IS LOCATED 1560' N AND 290' W.  
FROM THE SE CORNER OF SECTION 8.

**FINAL PROOF SURVEY**  
UNDER

**TRANSFER 5208**

IN NAME OF

.....**PEGGY M. SATTERBERG**.....

Surveyed Aug. 5..... 1983., by *V.L. Church*.....