


T.15 S., R.13 E.W.M
 Scale: 4" = Approx. 1 mile


F-5213

28
RECEIVED

MAR 3 1983
 WATER RESOURCES DEPT.
 SALEM, OREGON

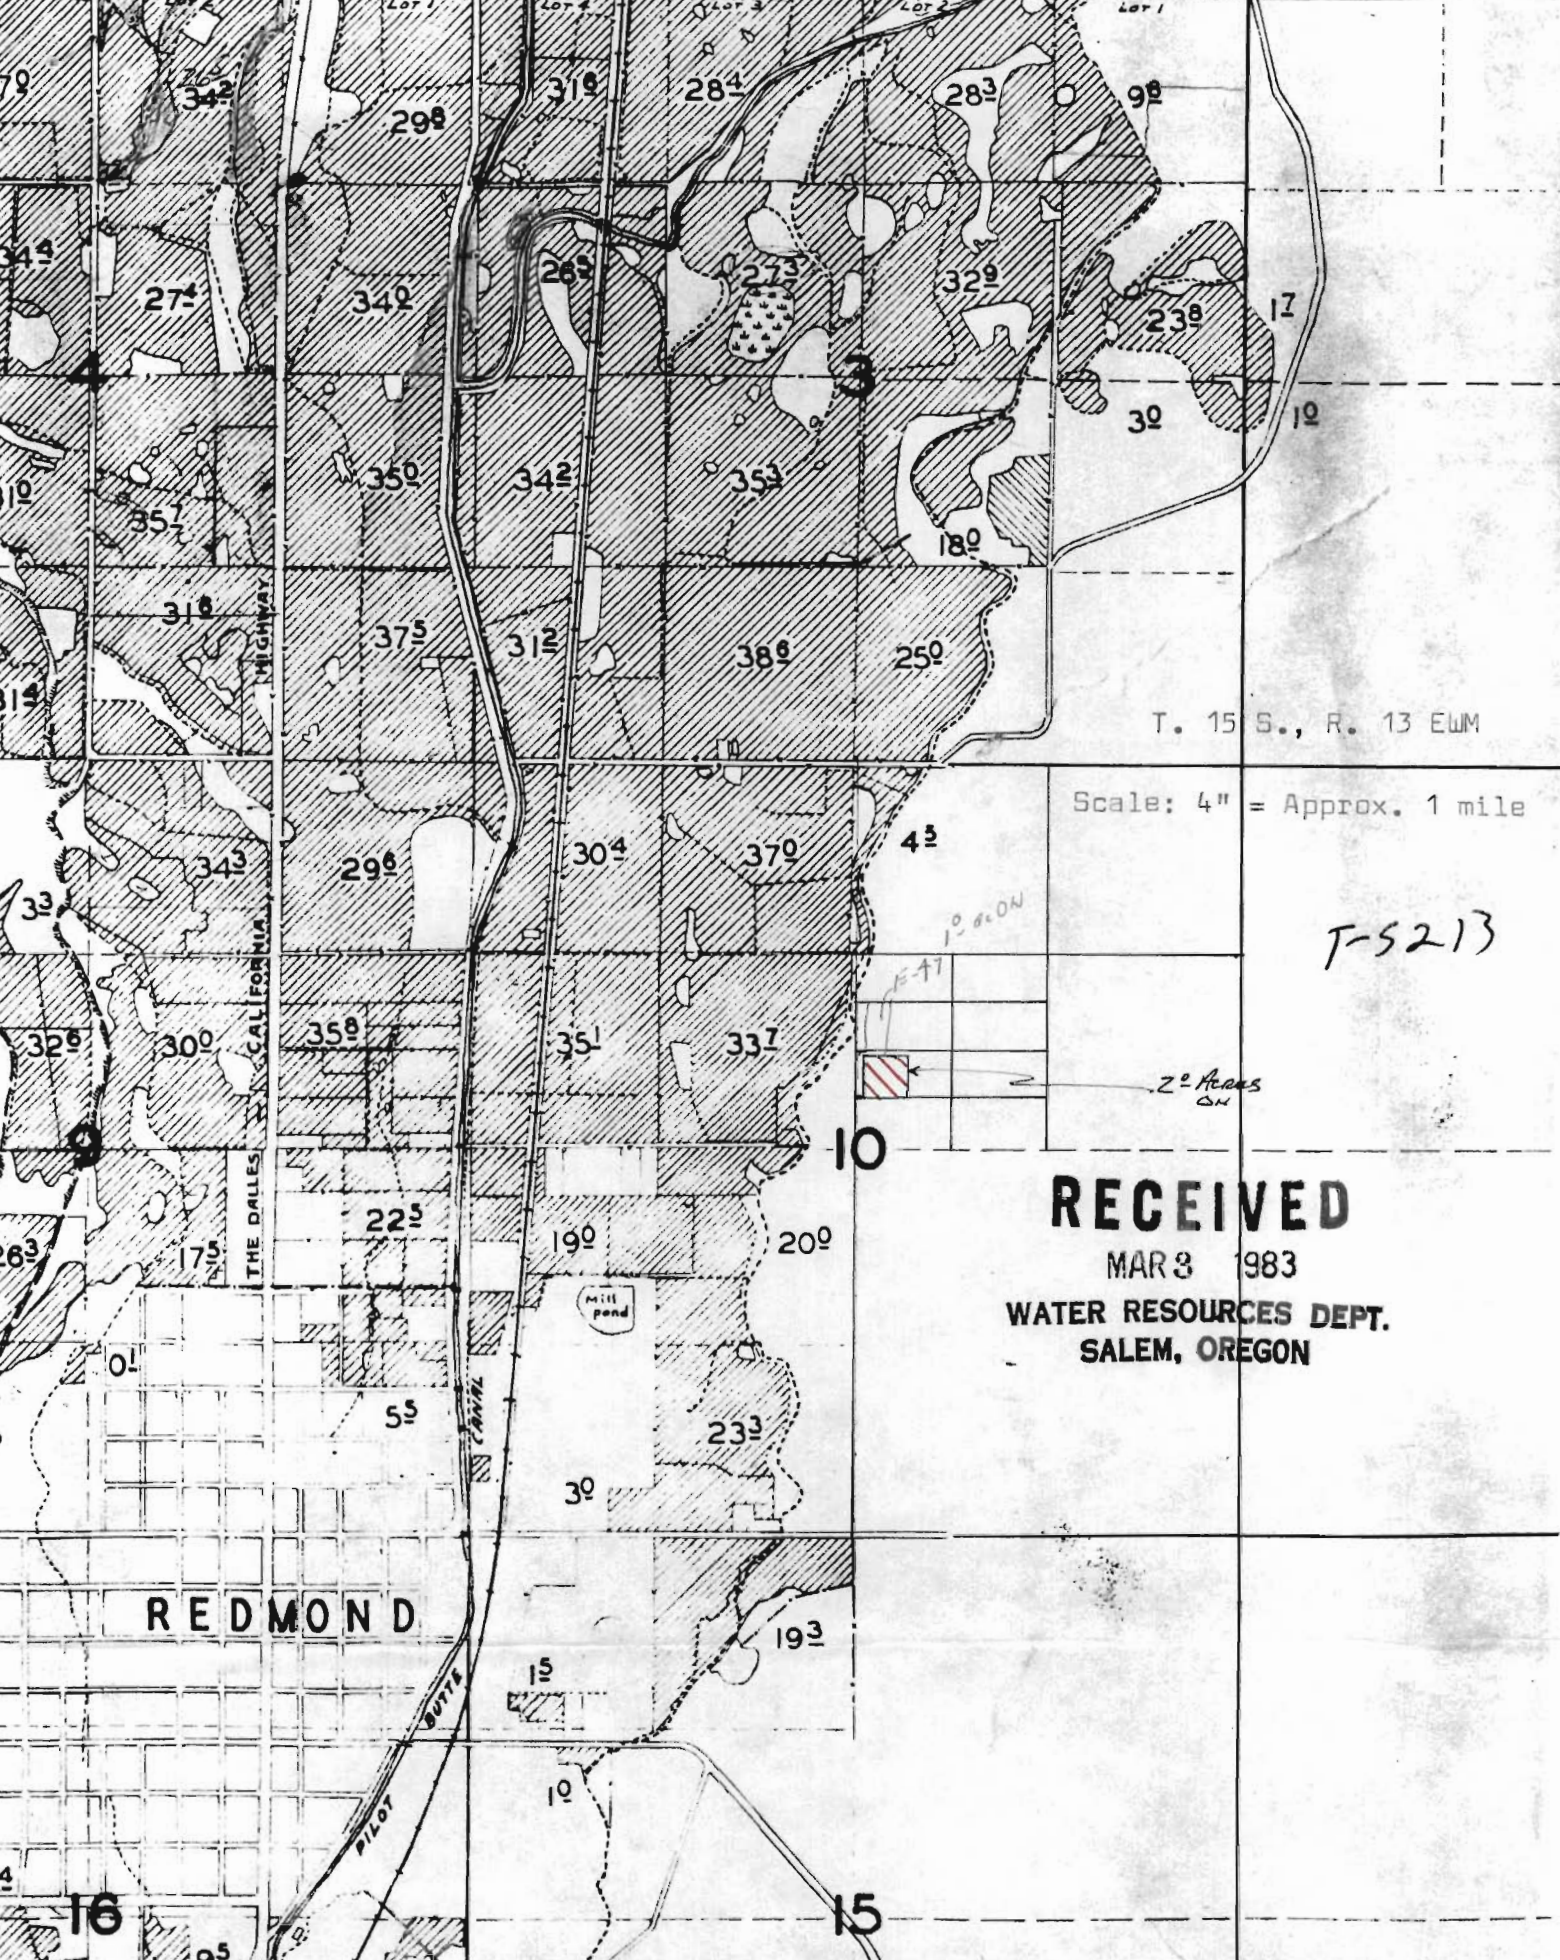

T. 15 S., R. 13 E/W

Scale: 4" = Approx. 1 mile

T-5213

RECEIVED

MAR 3 1983

WATER RESOURCES DEPT.
SALEM, OREGON

2 Acres
DN

10

REDMOND

16

15