


T. 39 S., R. 8 W., W. M.

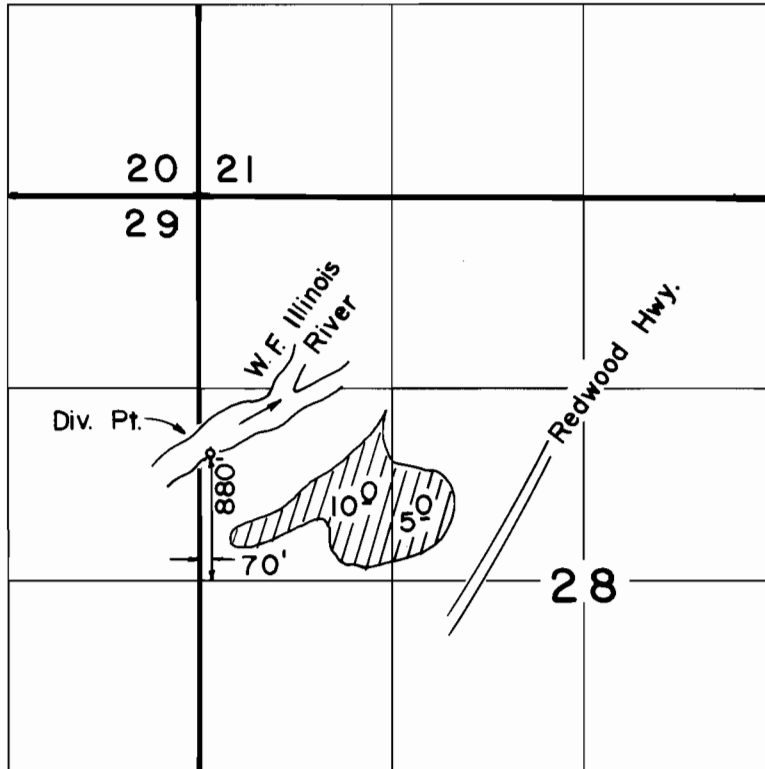

Scale: 1" = 1320'

FINAL PROOF SURVEY
UNDER

TRANSFER NO. 5229
Application No. 64974 Permit No. 47602
IN NAME OF

ROUGH & READY TIMBER CO.

Surveyed JUL...10. 1986, by B...S...JAMES...