


T. 38 S., R. 1 W., W. M.

Sec. 34

SE 1/4 NW 1/4

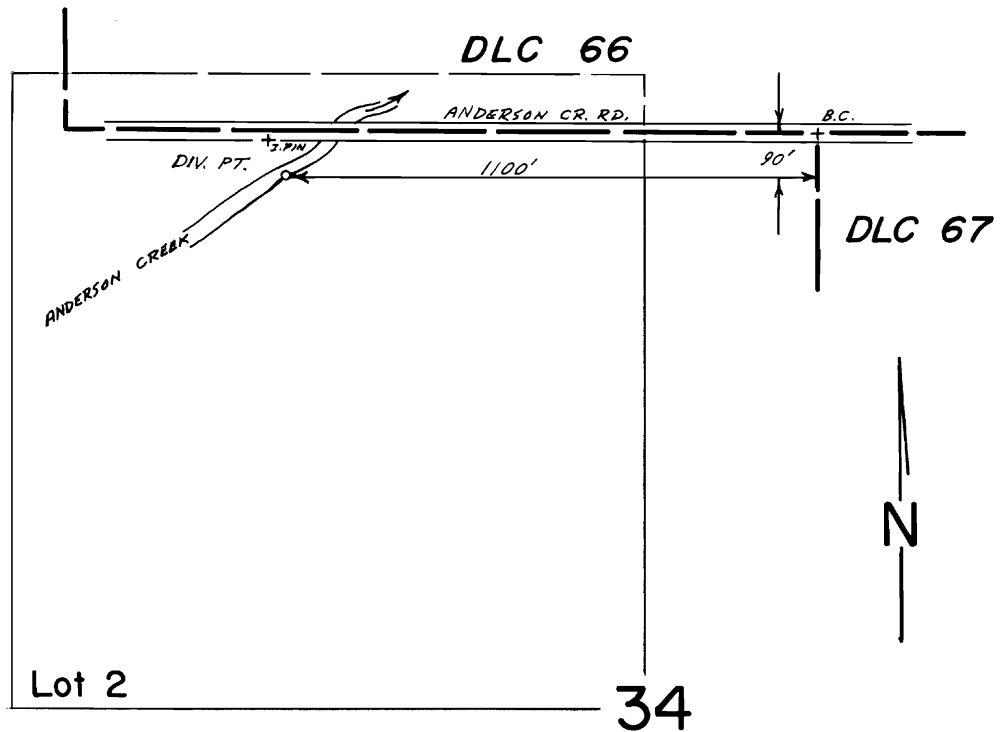

Scale 1" = 400'

FINAL PROOF SURVEY
UNDER

Transfer No. 5232

Application No. Permit No.
IN NAME OF

EDWARD W. & BETTY A. BRAIN

Surveyed March 20, 1986, by B.S. JAMES