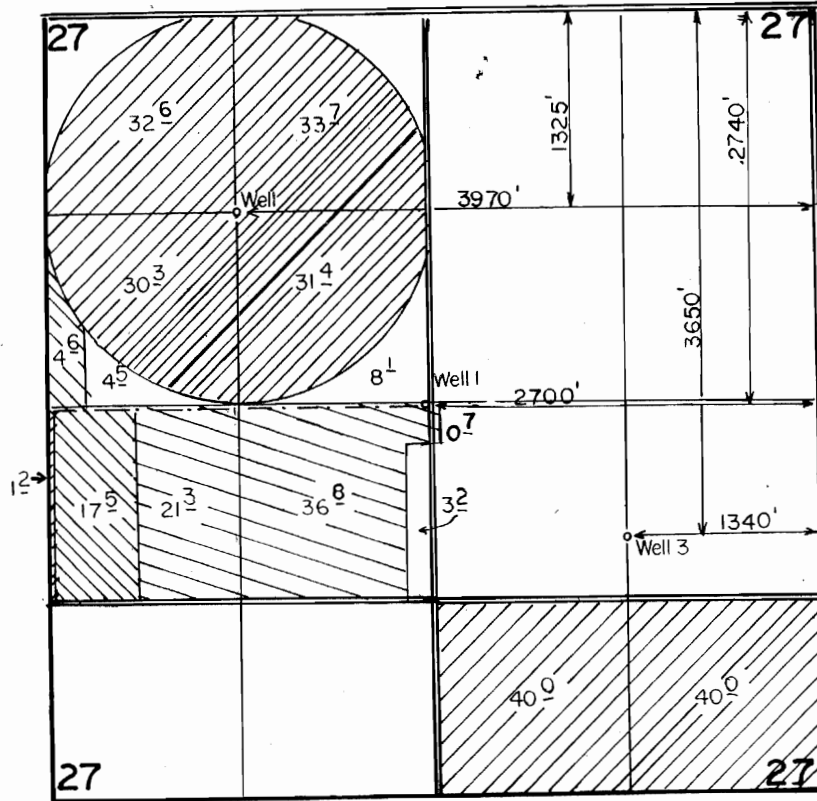

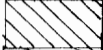



T.27S., R.17E., W.M.



SCALE: 1"=1320'

209.2		Permit G-10224
222		Transfer 5240
58.8		Transfer 5239

FINAL PROOF SURVEY

UNDER

TRANSERS NO 5239
5240

Application No. G:10929 Permit No. G:10224...
IN NAME OF

.....INTERSTATE PRODUCTION CREDIT.....

Surveyed OCT...10.. 1985... by B.W.BISHOP.....