


T.18S.,R.12E.,W.M.

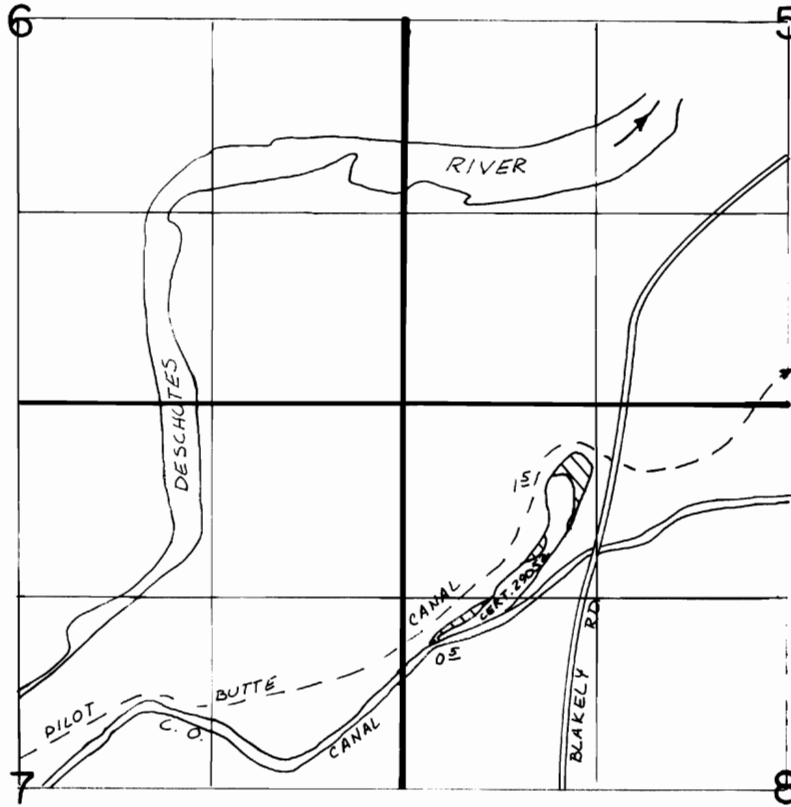

SCALE: 4"=1 mile



FINAL PROOF SURVEY
UNDER

Transfer 5252

Application No. Permit No.
IN NAME OF

CENTRAL OREGON IRRIGATION DISTRICT

Surveyed MAY 16... 19.84., by L. OLSON.....