


# TOWNSHIP 18 SOUTH, RANGE 13

T-5255

**RECEIVED**  
APR 25 1983  
WATER RESOURCES DEPT.  
SALEM, OREGON

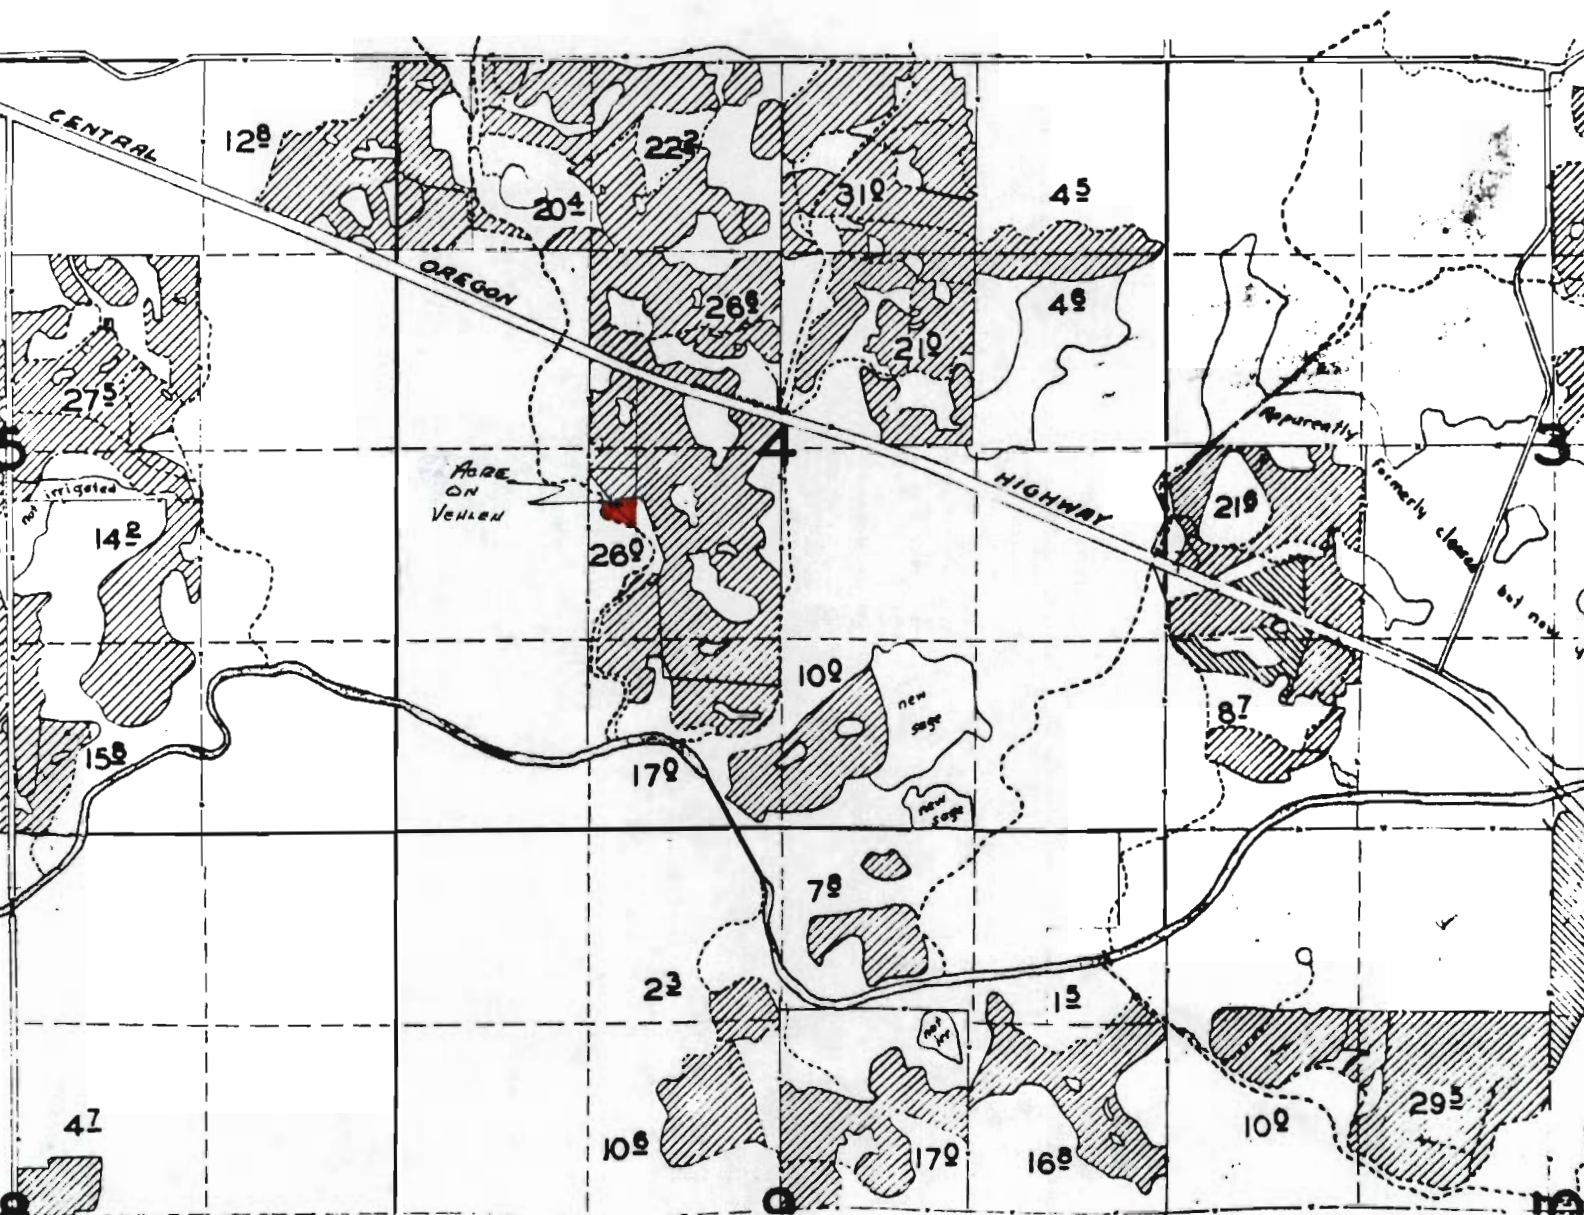

# SHIP 18 SOUTH, RANGE 12 EAST,

T-5255

