


TOWNSHIP 8 AND 9 SOUTH, RANGE 25 EAST, W.M.

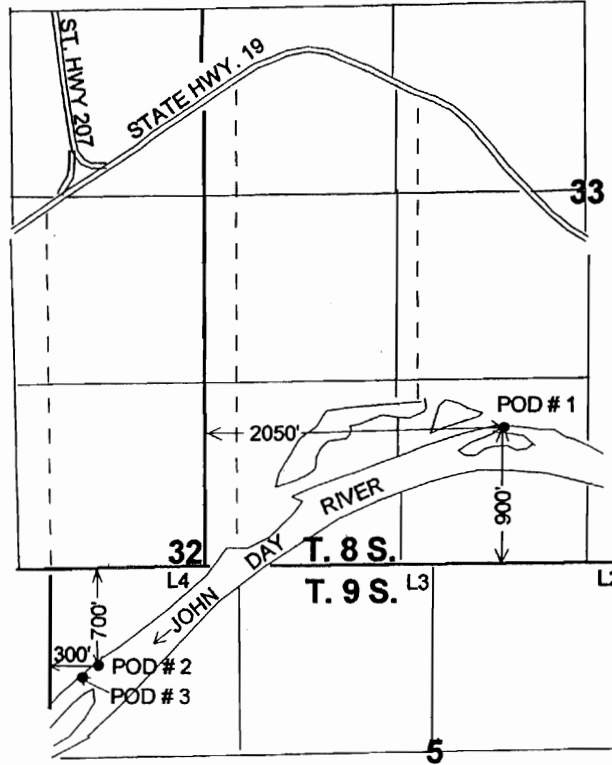

POD # 3 - 750' S. & 220' E. OF THE NW CORNER, LOT 4, Section 5

FINAL PROOF SURVEY
 UNDER
 TRANSFER 5258
 IN THE NAME OF
 D. R. AND R. M. GOODELL
 Surveyed: May 02, 2002 by: J. Miller

RECEIVED
 APR 03 2003
 WATER RESOURCES DEPT.
 SALEM, OREGON

7/26/06 JWG
 41069-179-48 & 49R JM 3-19-2003