


T 13 & 14 S, R 5 W, WM

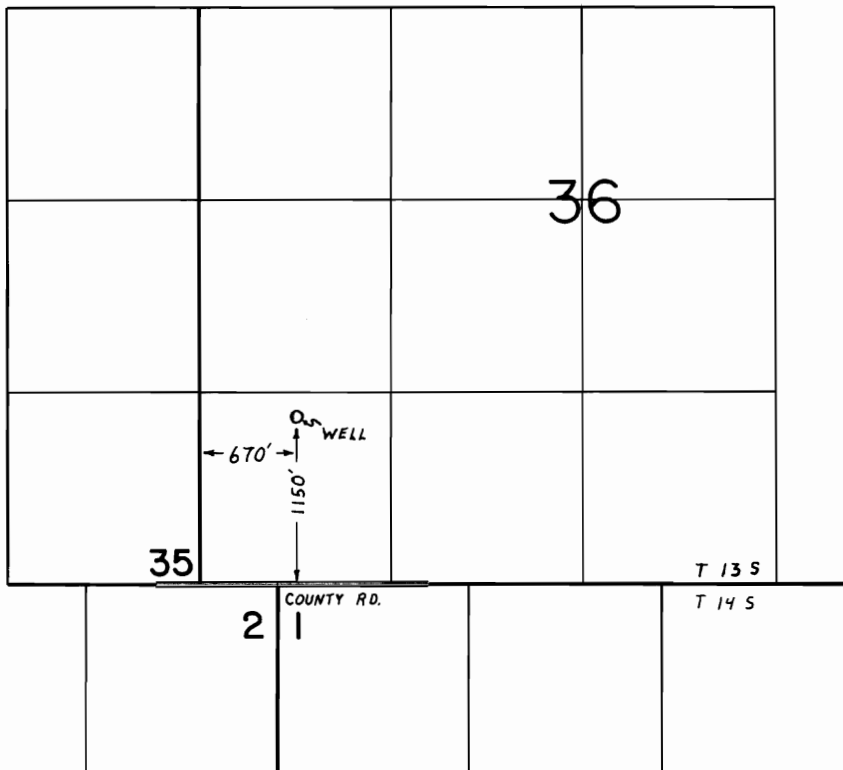

SCALE
1"=1320'

FINAL PROOF SURVEY

UNDER

Transfer No.5264.....

Application No. Permit No.

IN NAME OF

.....IVAN M. HORNING.....

Surveyed NOV. 30. 1987., by T.M. WARREN....