

RECEIVED

MAY 18 1983

WATER RESOURCES DEPT.
SALEM, OREGON

T-5266


Deer Trail Water Co.
Water Right Transfer
6.3 acres W $\frac{1}{2}$ -NW $\frac{1}{4}$
Sec. 32, T.17S., R.13 E.W.M.
Scale: 4" = Approx. 1 Mi.

29



BEND

ALFALFA

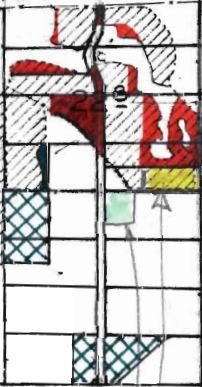

T-4974
1" off
1" on

32

33

OREGON

HIGHWAY