


T. 38 S., R. 1 W., W. M.
Sec. 33

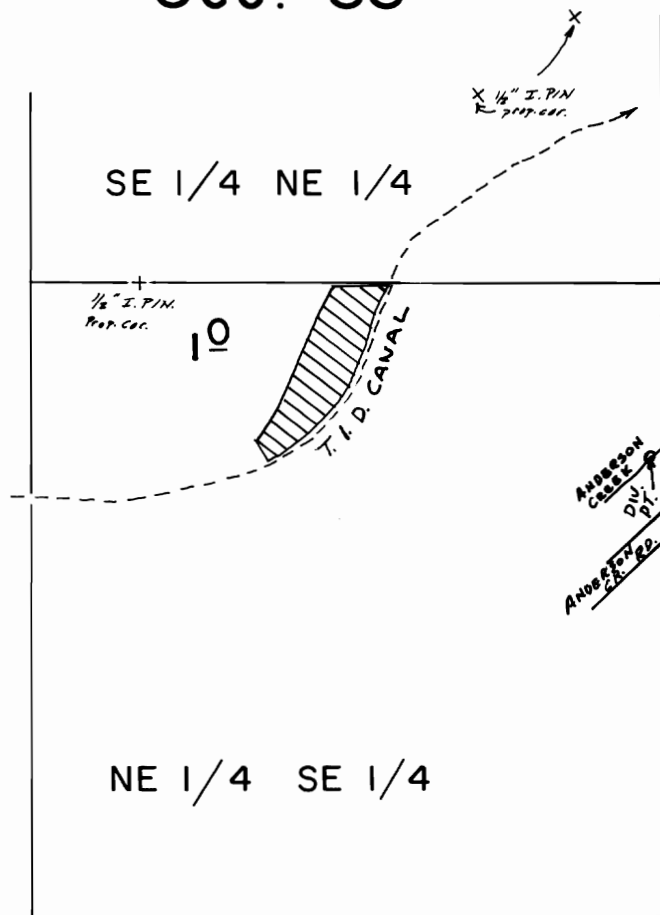

DIV. PT. : 360'S. & 30'W FROM C'1/4 COR. SEC. 33

Scale 1" = 400'

FINAL PROOF SURVEY
UNDER

Transfer No. 5270

Application No. Permit No.
IN NAME OF

.....MIKLOS GYENES.....

Surveyed March 6, 1986, by B.S. JAMES