


T.5S., R.12E., W. M.

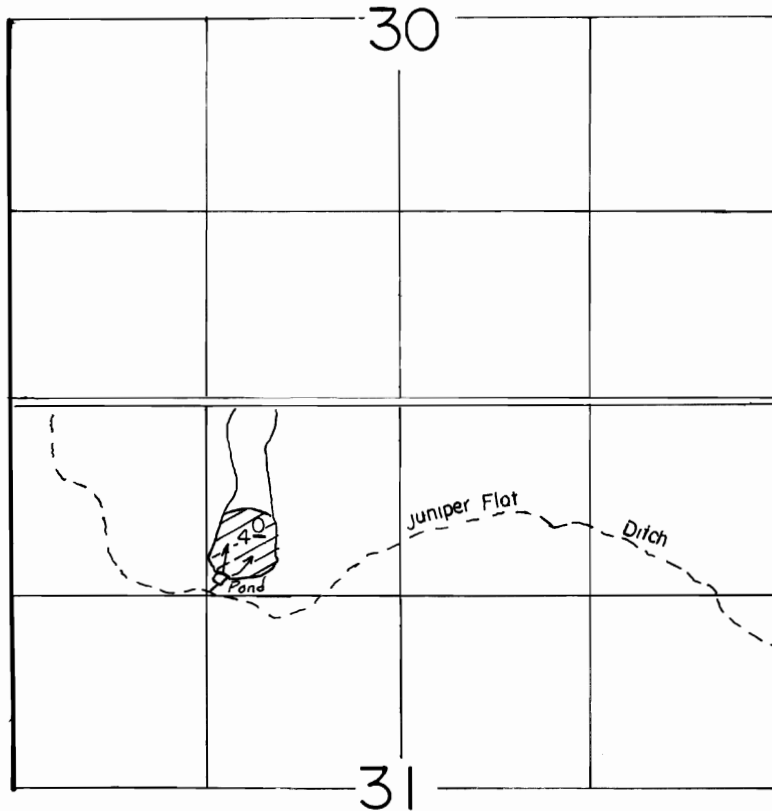

SCALE: 1" = 1320'

**FINAL PROOF SURVEY
UNDER**

TRANSFER NO 5284

Application No. Permit No.
IN NAME OF

..... ROBERT..... HOLMAN.....

Surveyed APRIL 23 1990., by L.M. TOLL.....