



T-5292

RECEIVED

JUN 16 1983

WATER RESOURCES DEPT.
SALEM, OREGON

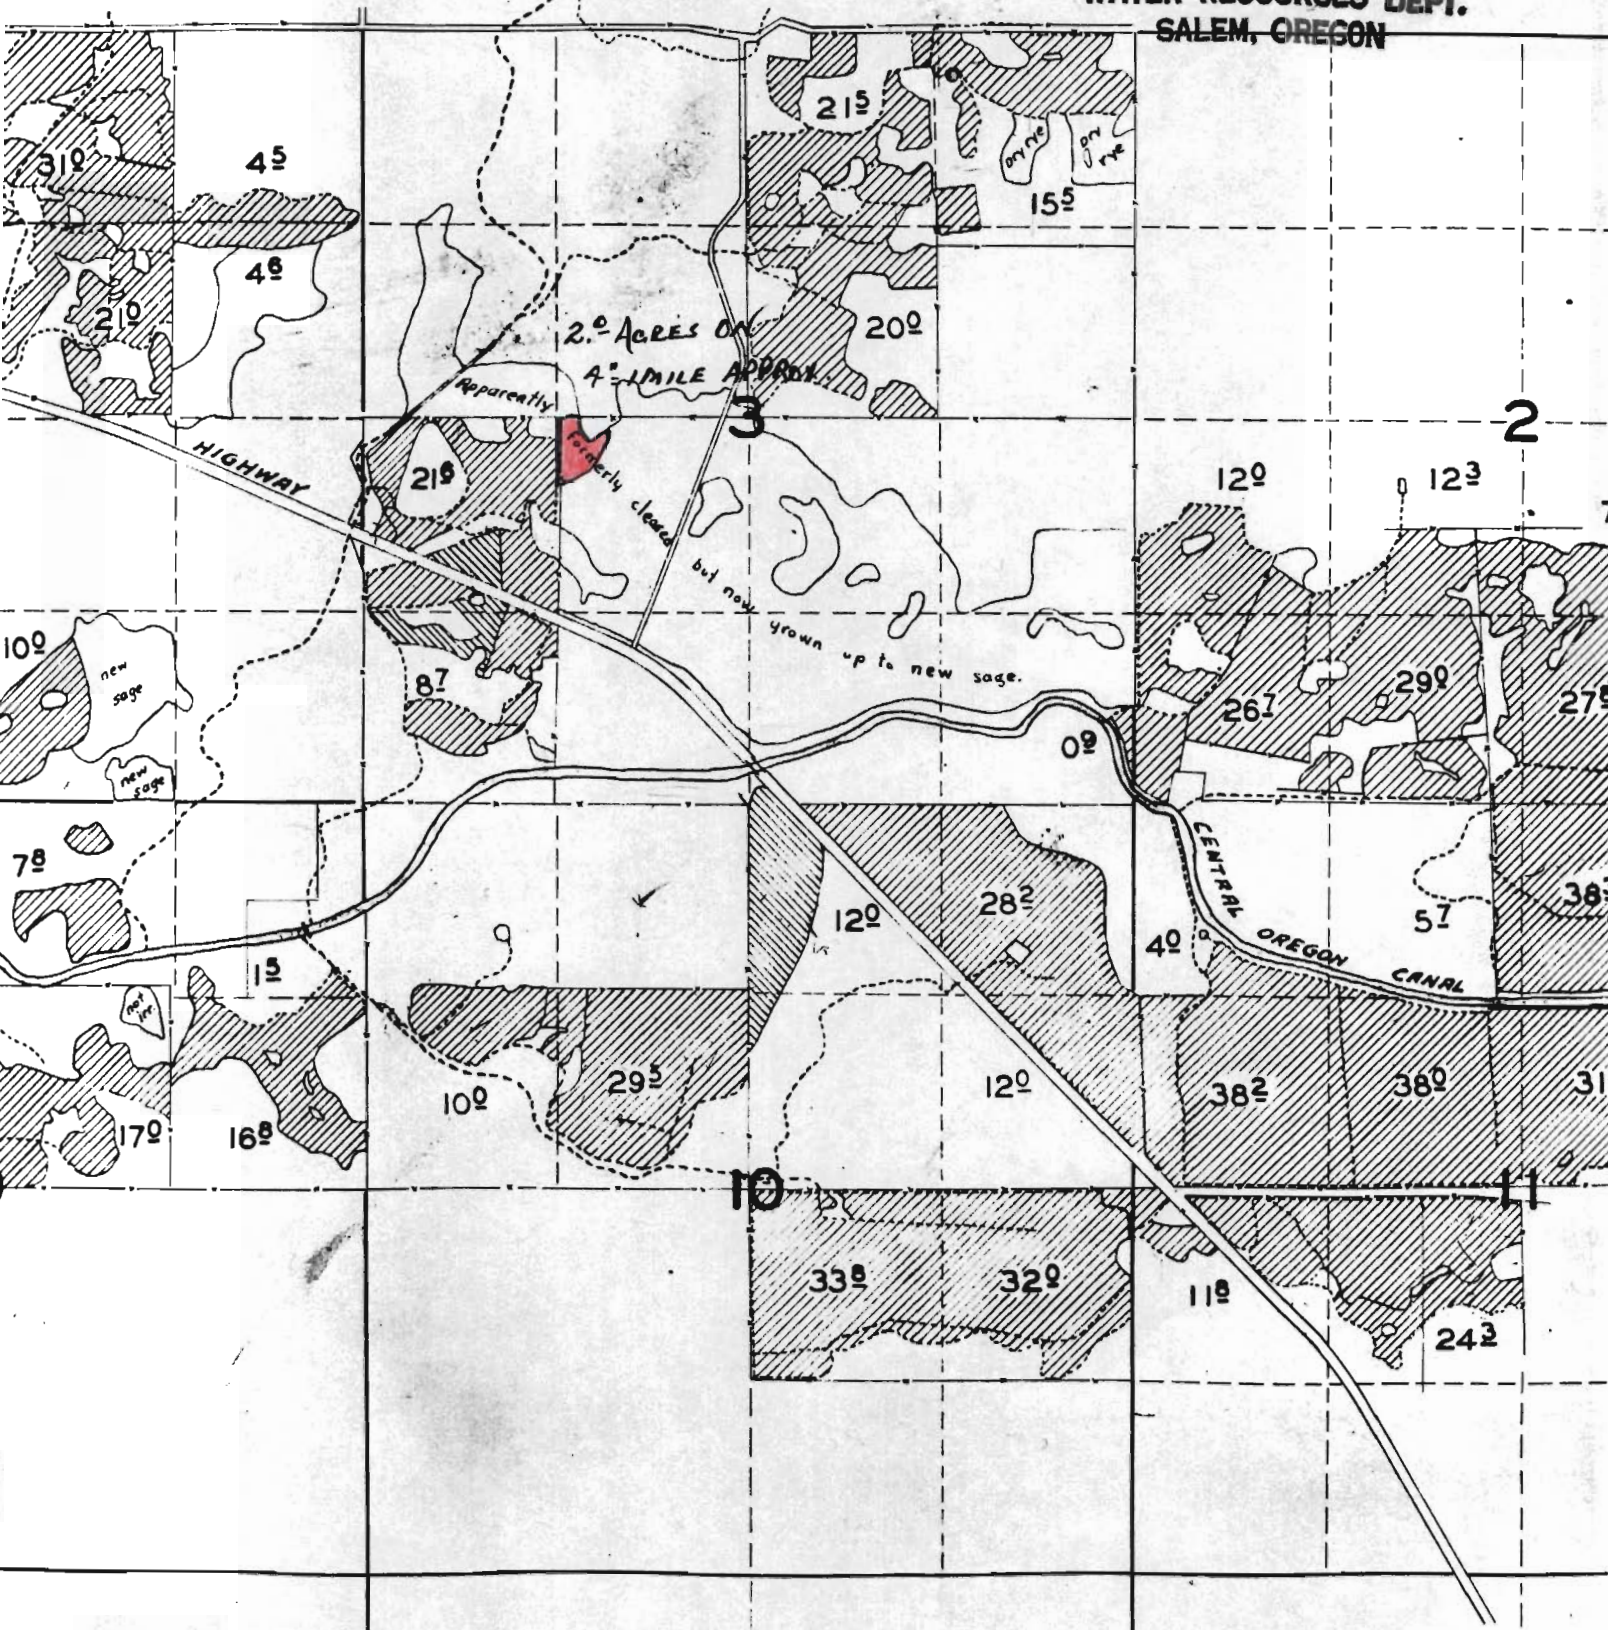

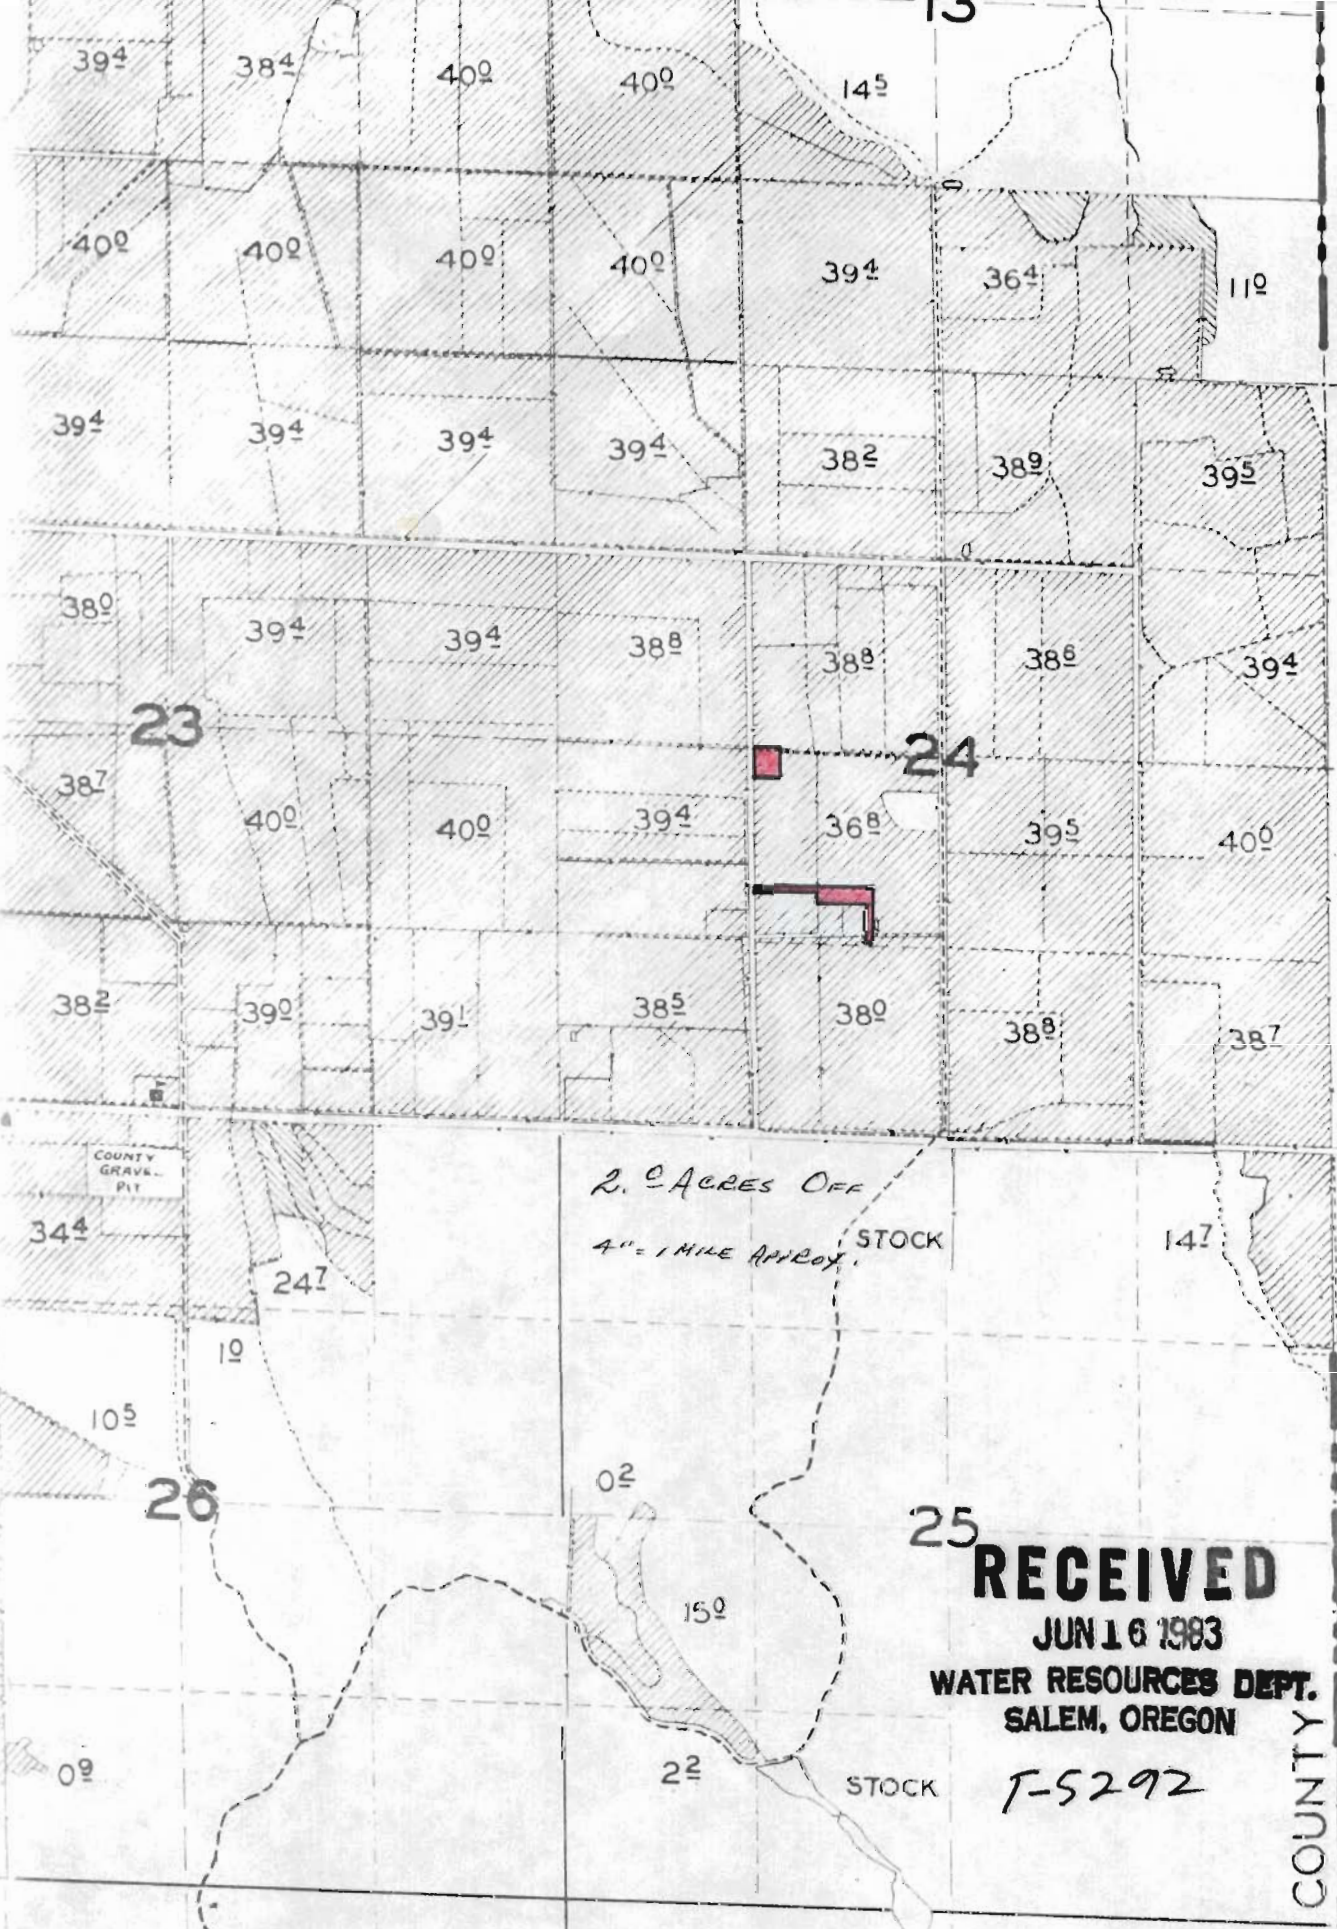

RECEIVED

JUN 16 1983

**WATER RESOURCES DEPT.
SALEM, OREGON**

T-5292

COUNTY COUNTY