


T.16S., R.11E., W.M.

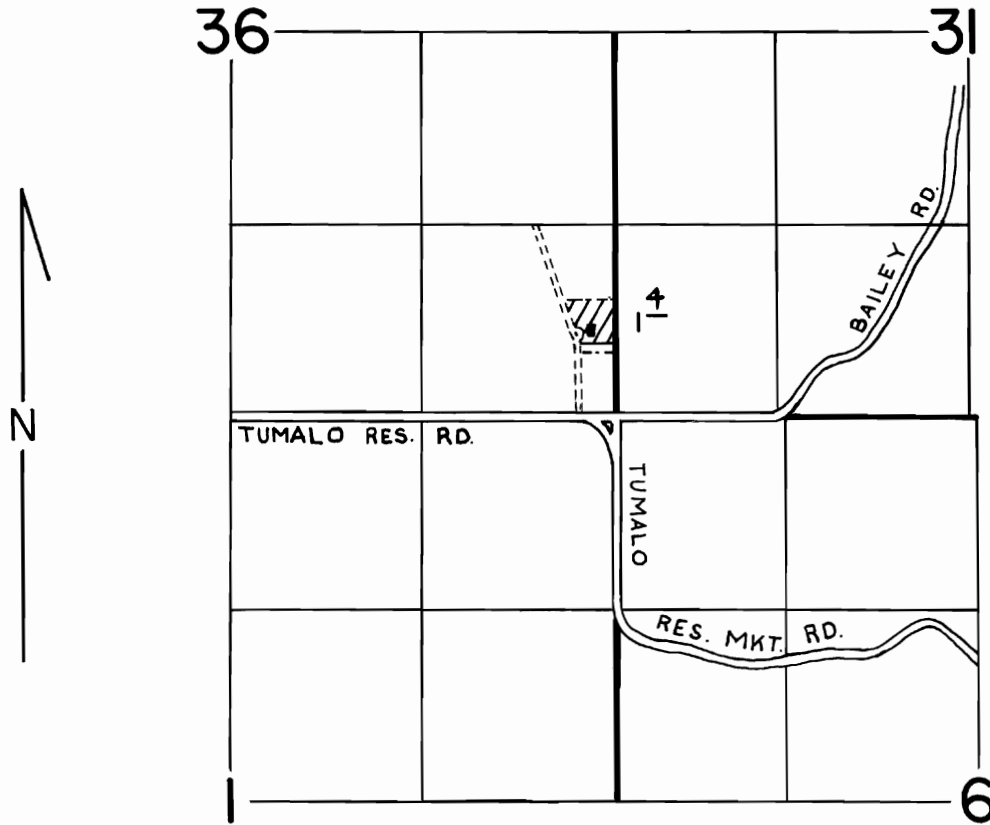

SCALE : 1" = 1320'

**FINAL PROOF SURVEY**  
UNDER

TRANSFER NO. 5296

IN NAME OF

**ROBERT TEPNER**

Surveyed SEPT. 5... 1985, by LESLIE OLSON...