


T.16S., R.11E., W.M.

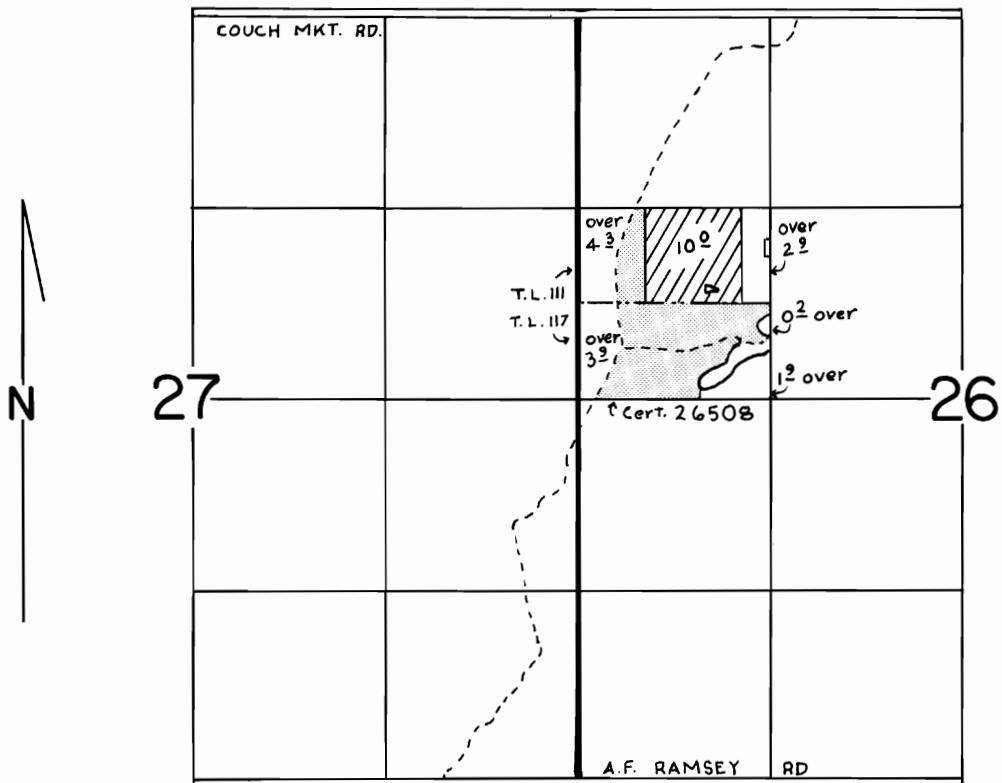

SCALE: 1" = 1320'

FINAL PROOF SURVEY UNDER

TRANSFER NO. 5298

IN NAME OF

WILLIAM B. & CONNIE M. CARTER

Surveyed MAY. 15. 1986., by MICHAEL J. MATTICK