


T. 40 S., R. 8 W., W.M.

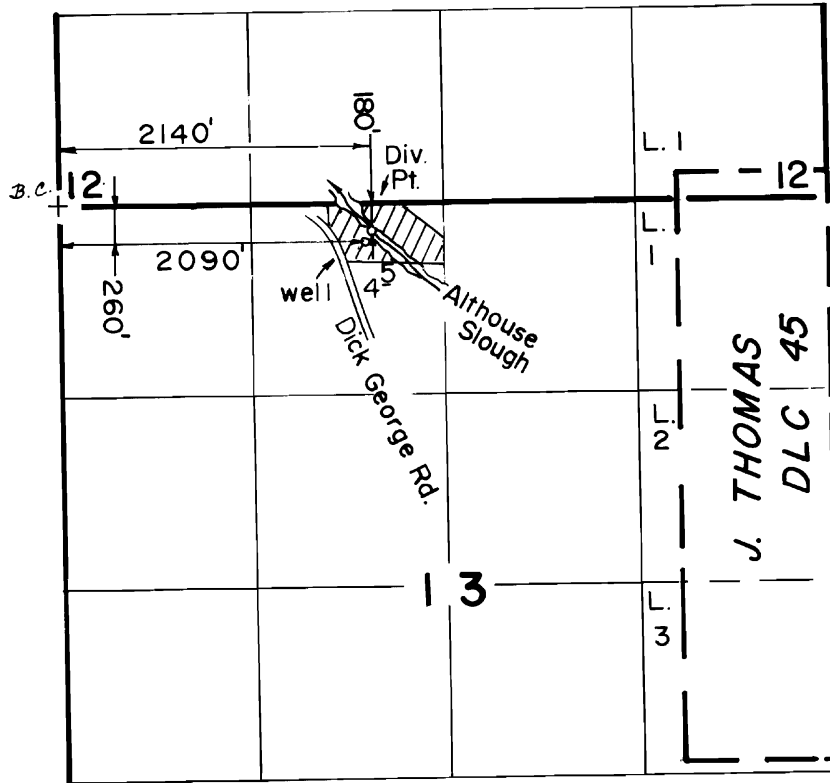

Scale: 1" = 1320'

**FINAL PROOF SURVEY**

UNDER

TRANSFER NO. 5305

Application No. G-11007 Permit No. G-10225

IN NAME OF

**ROBERT A. DASCH**

Surveyed APR. 2... 1986, by B. S. JAMES...