

RECEIVED

JUL 18 1968

WATER RESOURCES DEPT.
SALEM, OREGON

2.3 ACRES ORA


T-3387 5322 ON

1.2 ACRE ON

5 ACRE ON

T-5320

13

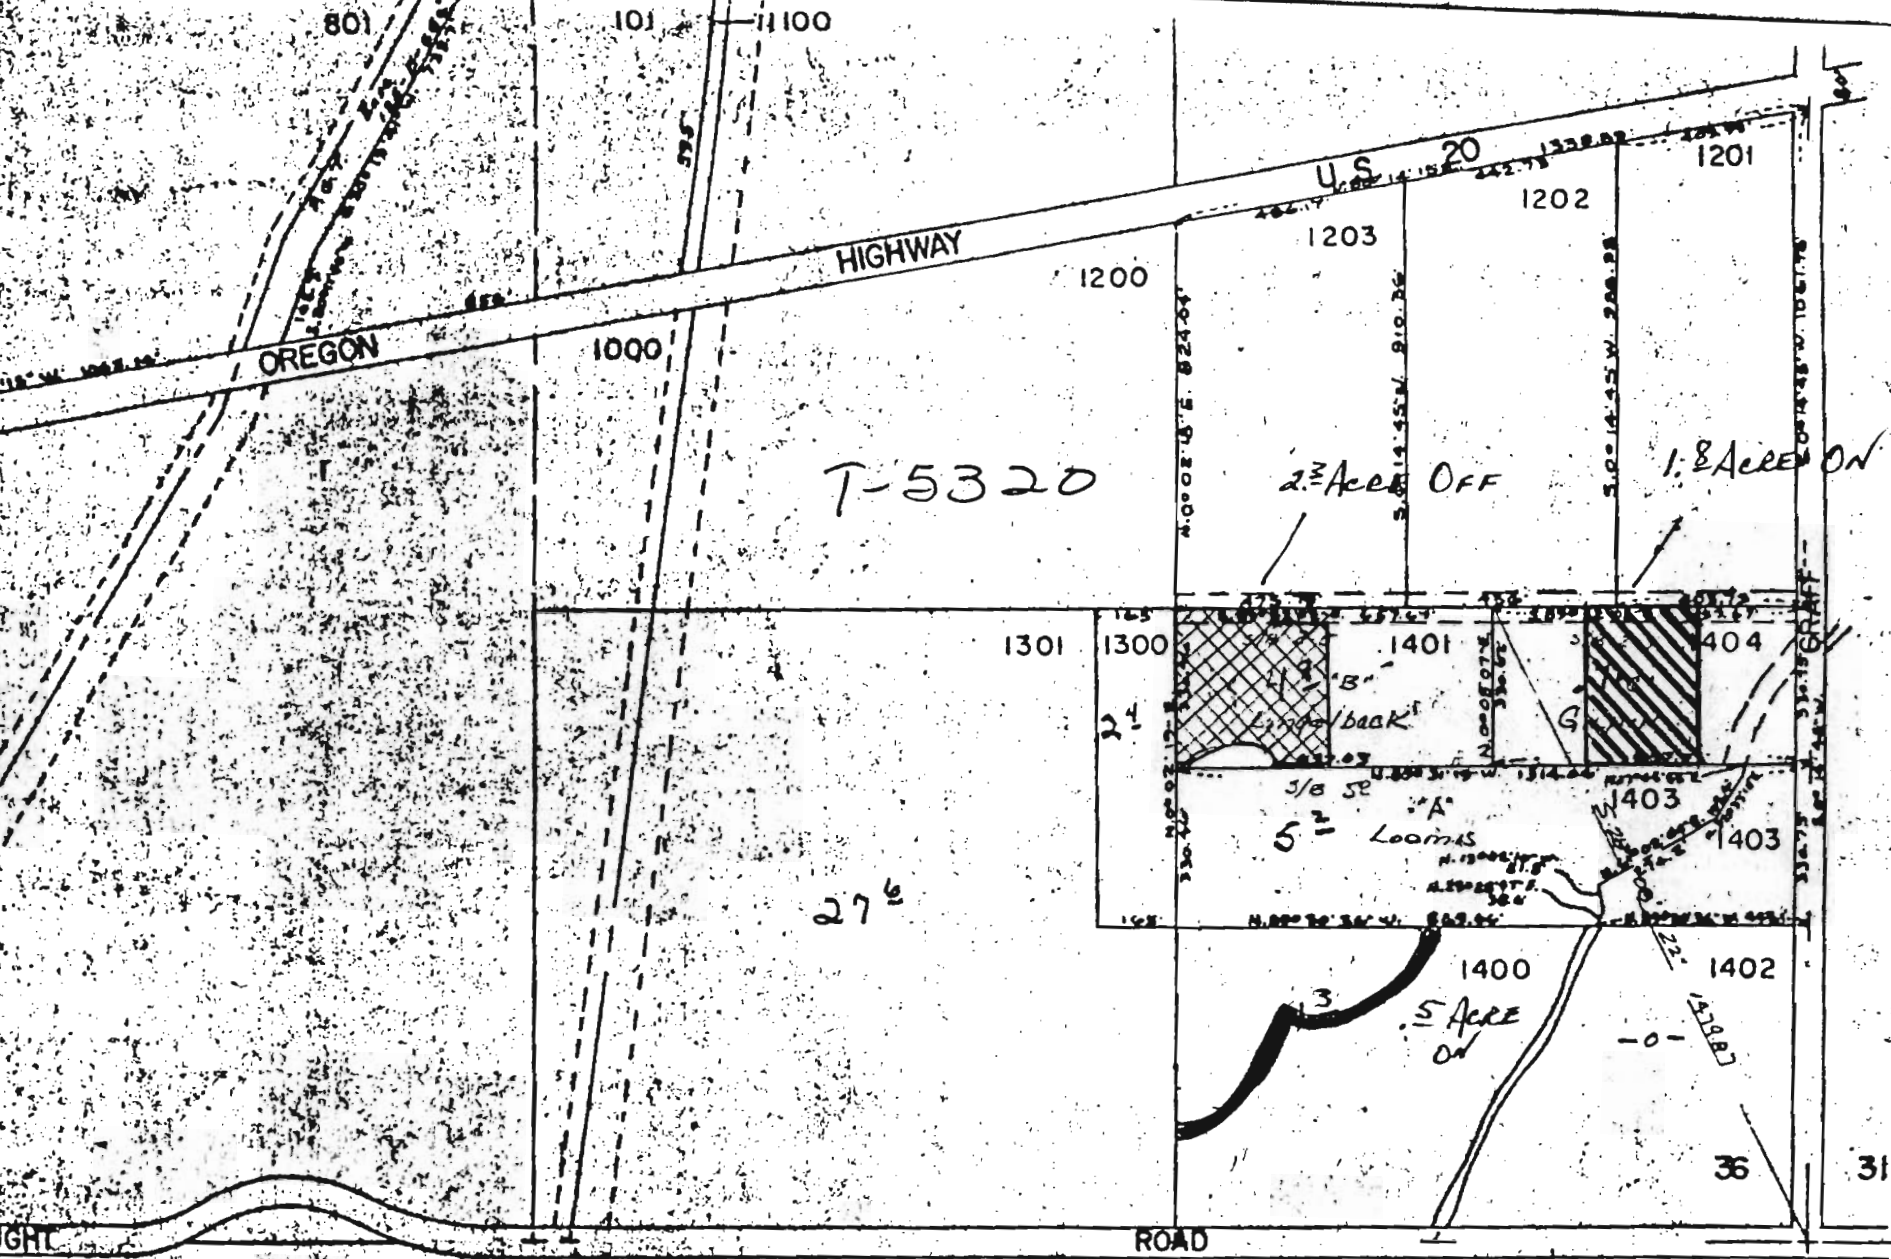

See Map 18 2

RECEIVED

JUL 18 1983

WATER RESOURCES DEPT.
SALEM, OREGON

6

17