


T.27S., R.6 W., W.M.

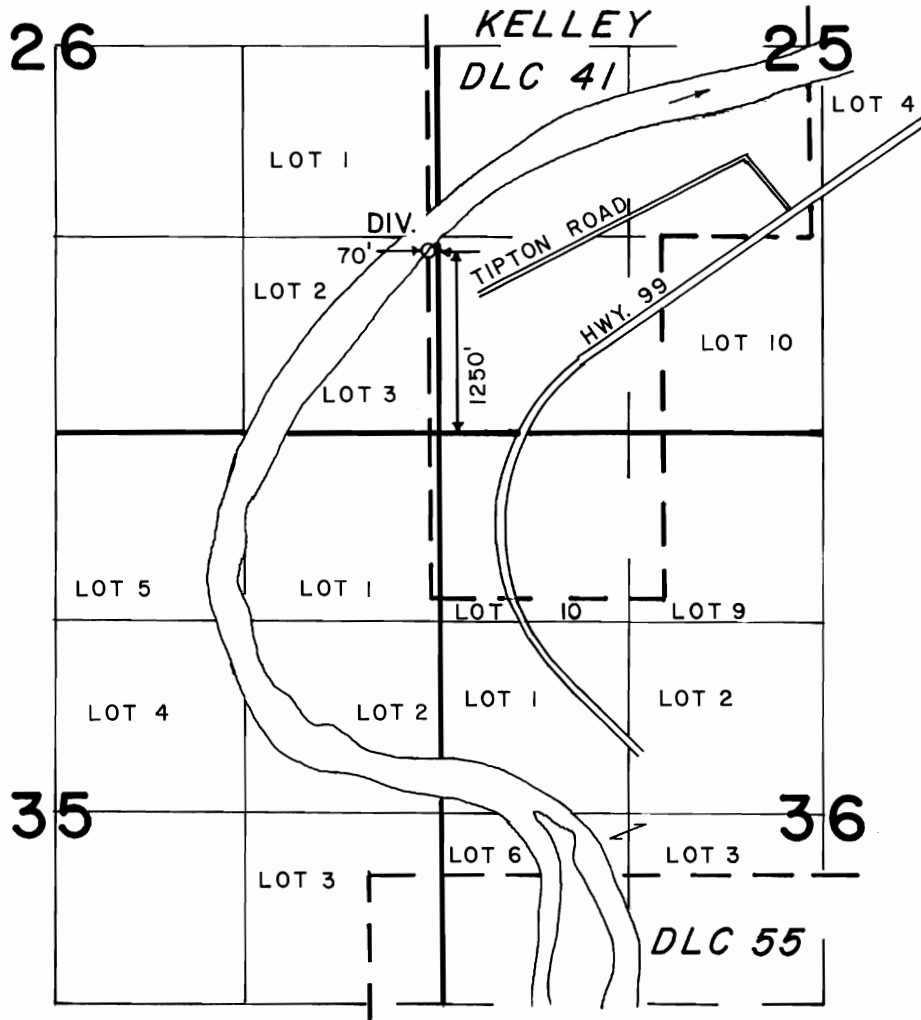

SCALE: 4" = 1 MILE

FINAL PROOF SURVEY UNDER

TRANSFER NUMBER 5324
IN NAME OF

REX GARRIOTT

Surveyed OCT. 7. 1986. by J. R. KAUPPILA