



RECEIVED

JUL 18 1983

T. 5N., R. 35E., W. M. WATER RESOURCES DEPT.  
SALEM, OREGON

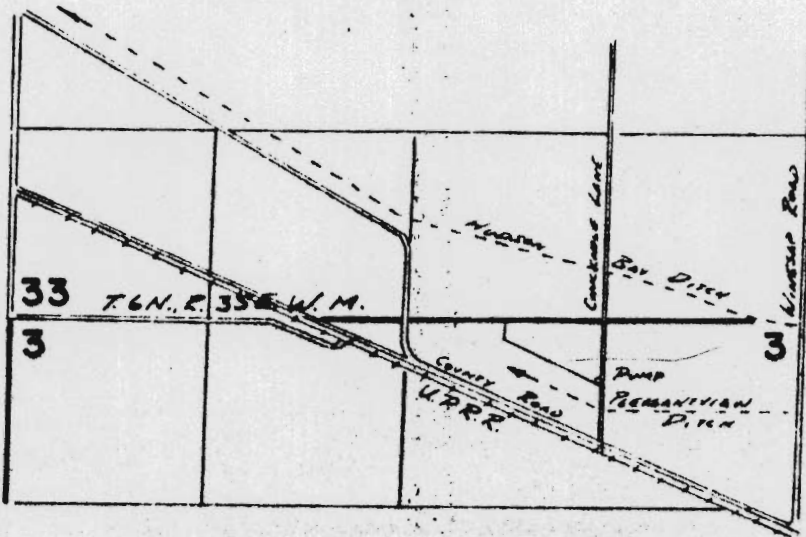

T. 5N., R. 35E., W.M.

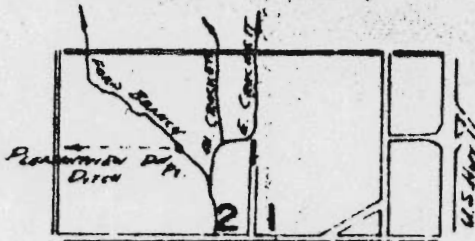

Dir. Pt. Loc. 670'S & 500'W FROM NE Cor. Sec. 2  
FROM

T-5325