


T.17S. R.12E. W.M.

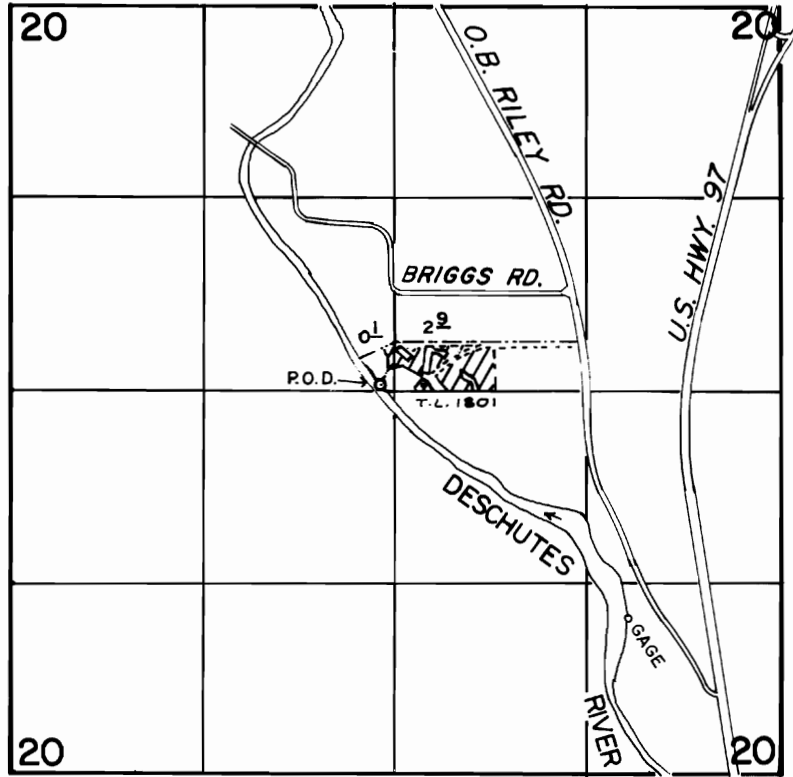

DIV. PT. IS 40' NORTH & 100' WEST FROM C 1/4 COR.

FINAL PROOF SURVEY UNDER

TRANSFERS 4520 & 5328

IN NAME OF

LAWRENCE BAKER

Surveyed SEPT. 17... 1985., by LESLIE OLSON....