


1" = 400'

1.0 OFF (C. 26050, 1913)

1.0 OFF (C. 26050, 1913)

19 | 1 | 2.0 ON (C. 26050, 1913)

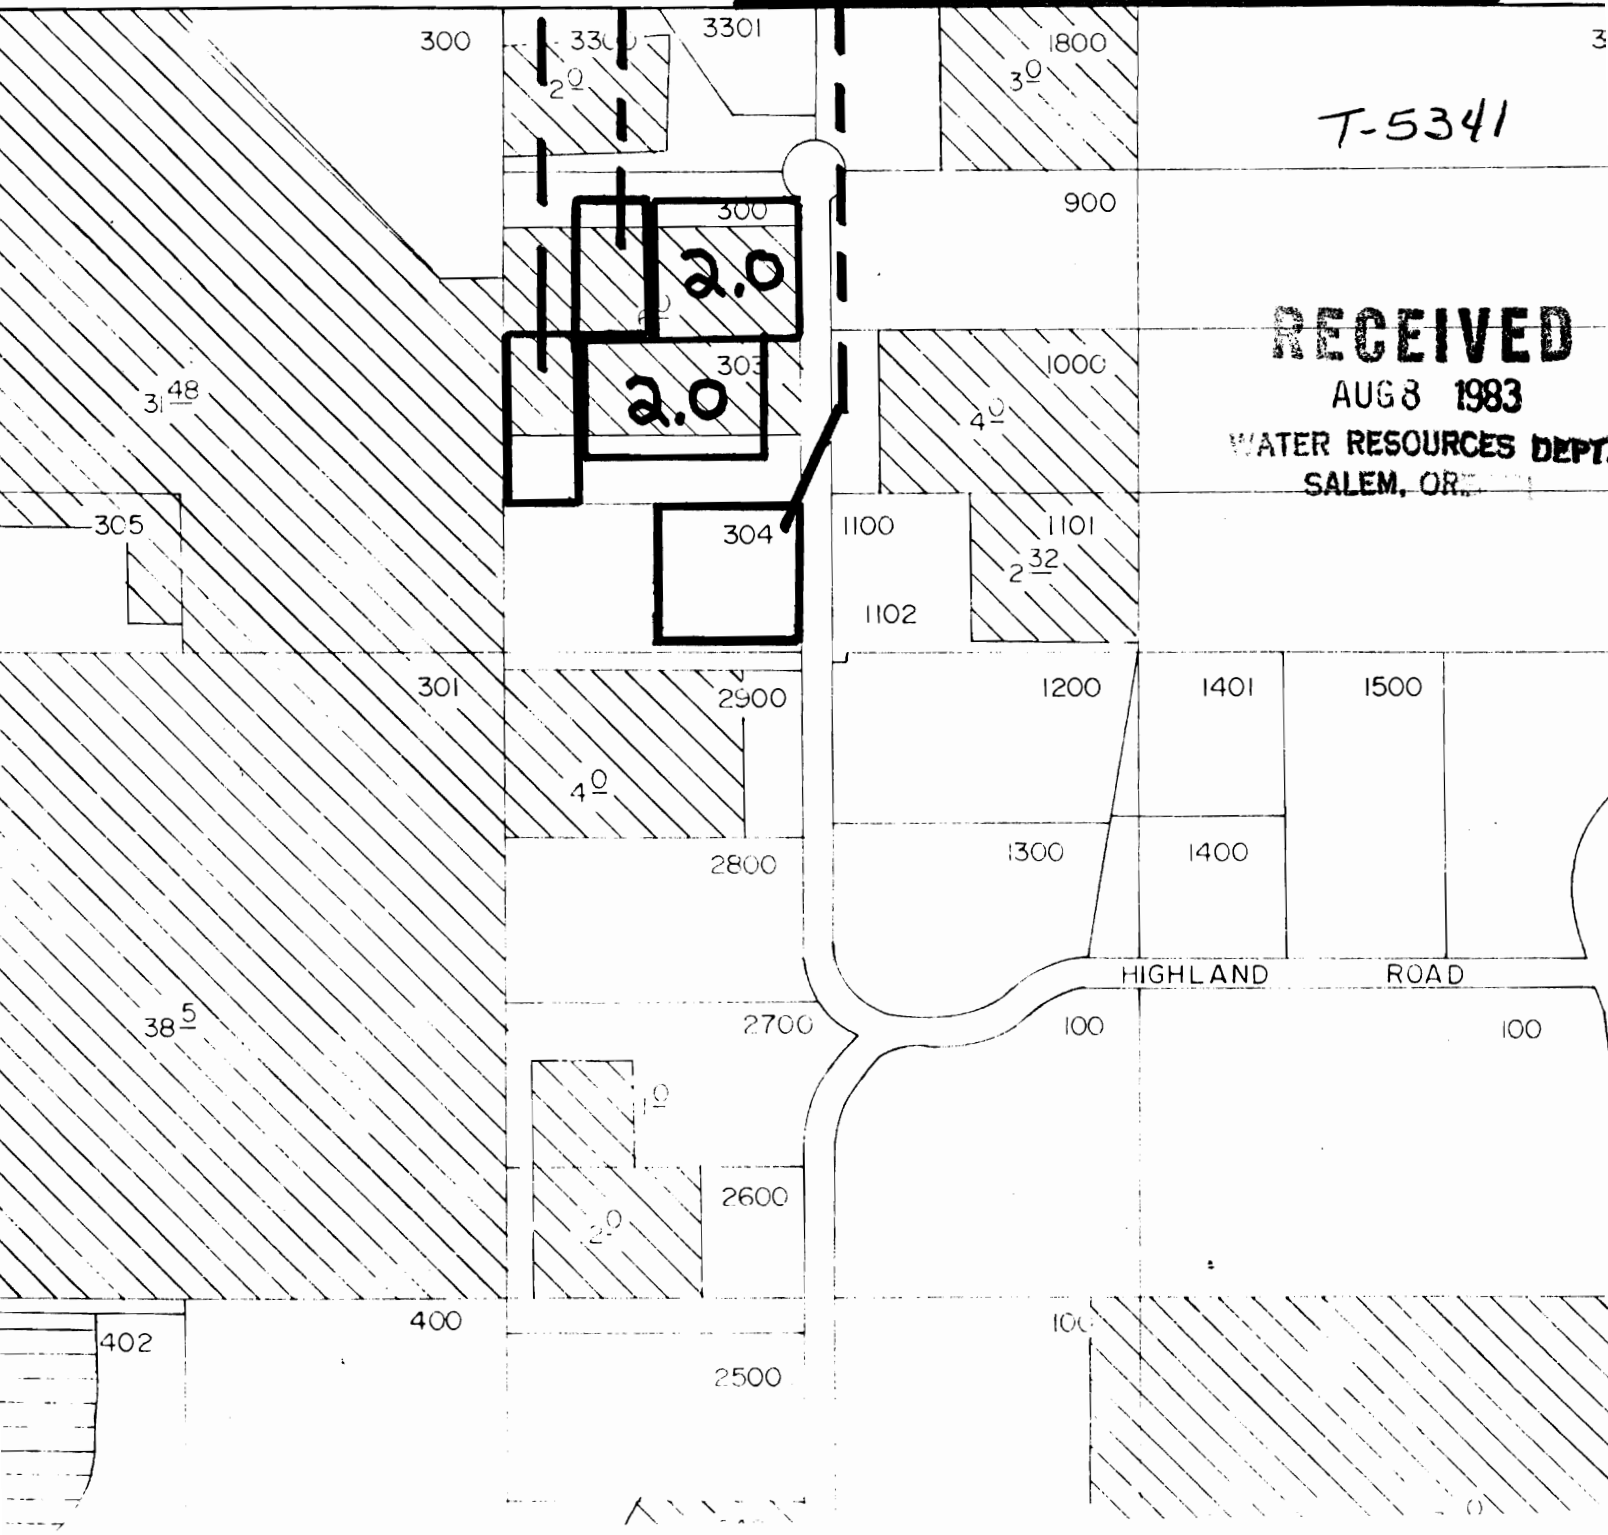

RECEIVED
 AUG 8 1983
 WATER RESOURCES DEPT
 SALEM, OR.

T-5341