

SECTION 1 T.17S. R.11E. W.M.

1" = 400'

.8 ON (c. 31410, 9/1900)
.9 OFF (c. 31410, 9/1900)

.4 OFF (c. 26508, 9/1900)

36
2.0 OFF (c. 31410, 9/1900)

RECEIVED
AUG 8 1983
WATER RESOURCES DEPT.
SALEM, OREGON
T-5342



0.4 ON (C. 26508, 9/1900)

2.1 ON (C. 31419, 9/1900)

SECTION 2 T.17 S. R.11 E. W.M.

1" = 400'


0.4 OFF (C. 26508, 9/1900)

2.1 OFF (C. 31419, 9/1900)

Exchange T-5342 - 2 1/2 acres from here to:

RELOCATE 6.2 T-4856 (C. 26508, 6/1900)

2.5 LEFT ON (Permit # 27840/41, 12/9/1961)

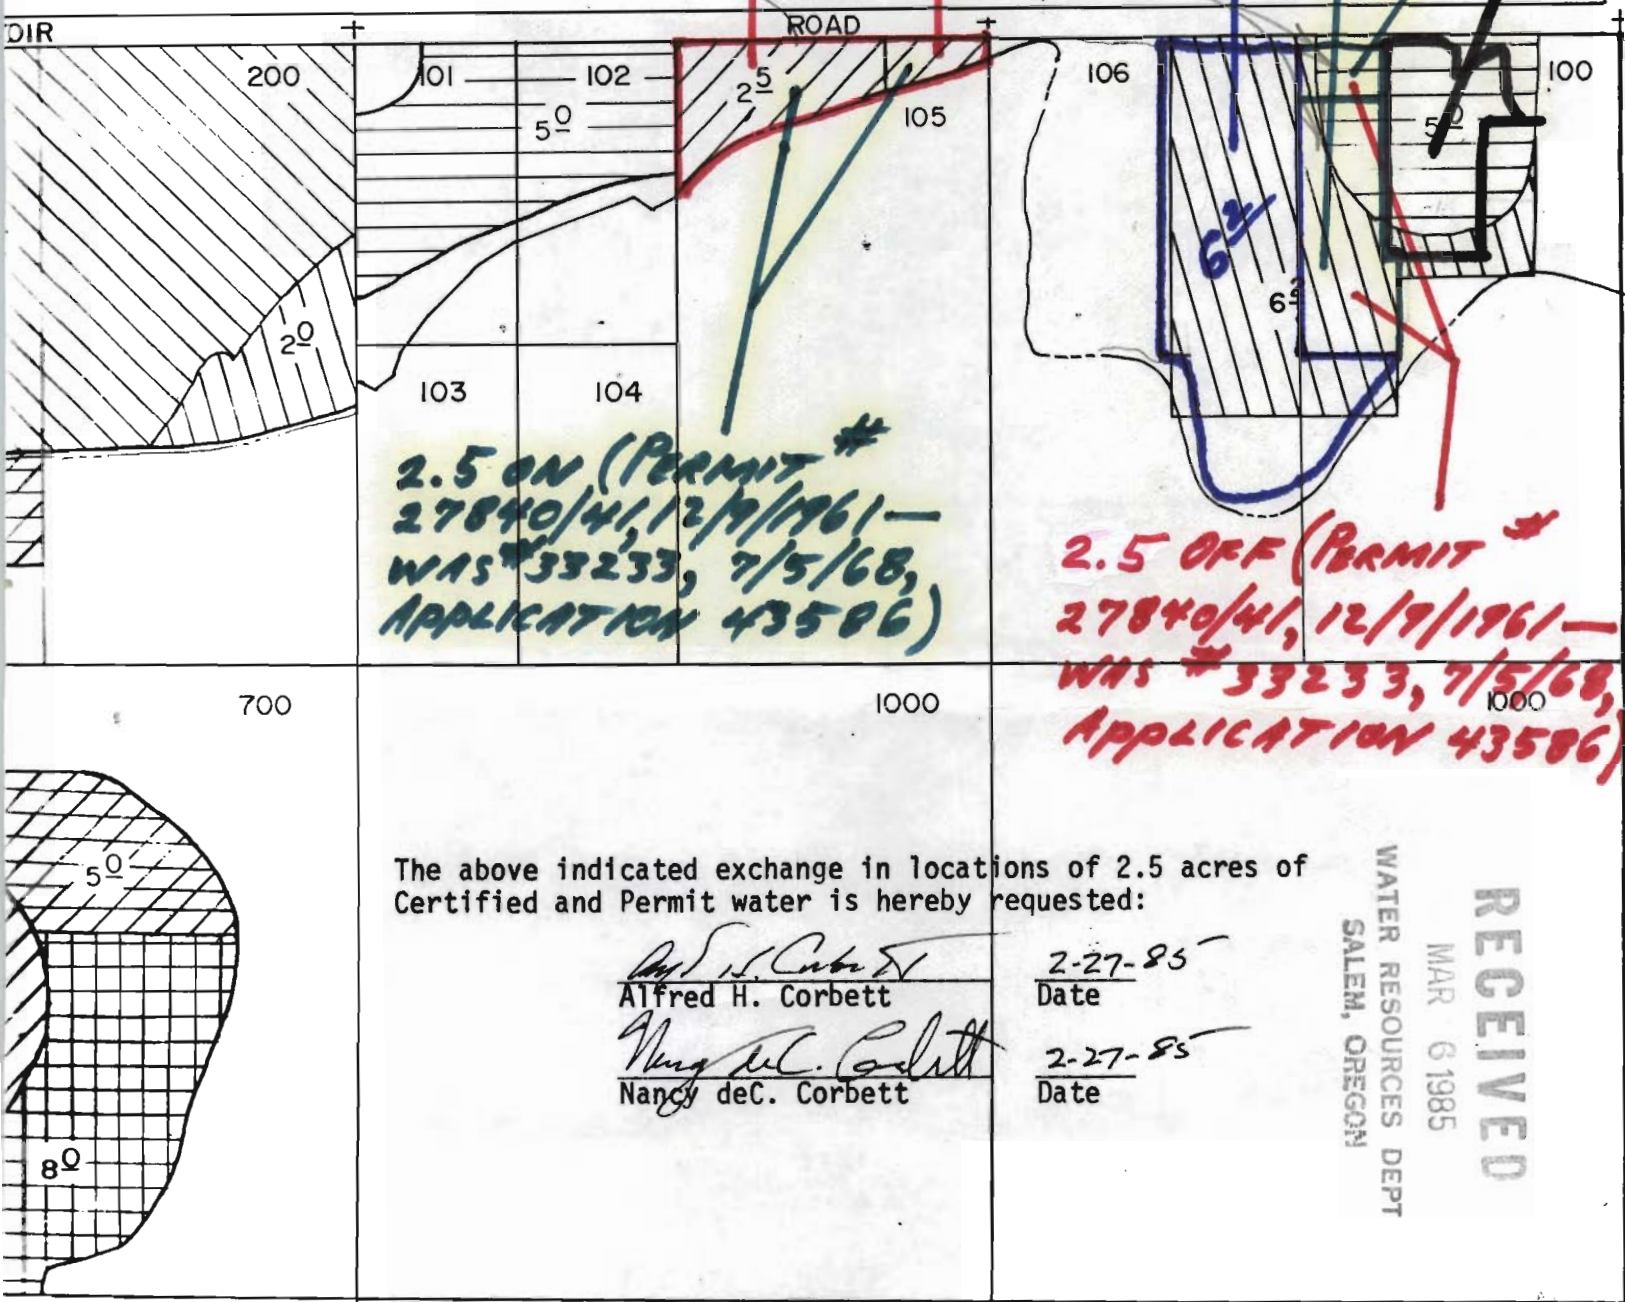

35

DIR

ROAD

200

101

102

2.5

105

106

100

20

103

104

6.2

6.2

2.5 ON (PERMIT # 27840/41, 12/9/1961 - WAS # 33233, 7/5/68, APPLICATION 43506)

2.5 OFF (PERMIT # 27840/41, 12/9/1961 - WAS # 33233, 7/5/68, APPLICATION 43506)

700

1000

1000

The above indicated exchange in locations of 2.5 acres of Certified and Permit water is hereby requested:


Alfred H. Corbett
Alfred H. Corbett

2-27-85
Date

Nancy deC. Corbett
Nancy deC. Corbett

2-27-85
Date

RECEIVED
MAR 6 1985
WATER RESOURCES DEPT
SALEM, OREGON

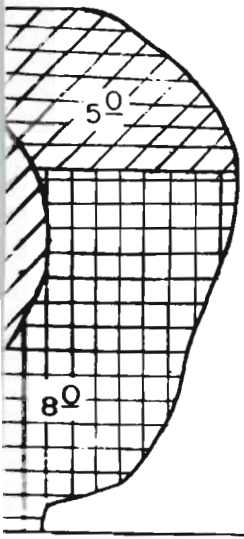

SECTION 2 T.17 S. R.11 E. W.M.

1" = 400'

.4 ON (c. 26508, 9/1900)

2.1 ON (c. 31410, 9/1900)

RECEIVED

AUG 8 1983

WATER RESOURCES DEPT.
SALEM, OREGON

T-5342

