

WATER RIGHT MAP


RECEIVED

FOR: BILL GILDOW
STAR ROUTE, BOX 385
FOREST GROVE, ORE. 97116

AUG 12 1983
WATER RESOURCES DEPT.
SALEM, OREGON

TOWNSHIP 1 NORTH, RANGE 4 WEST, W. M.

SECTIONS 7, 8, 17 & 18

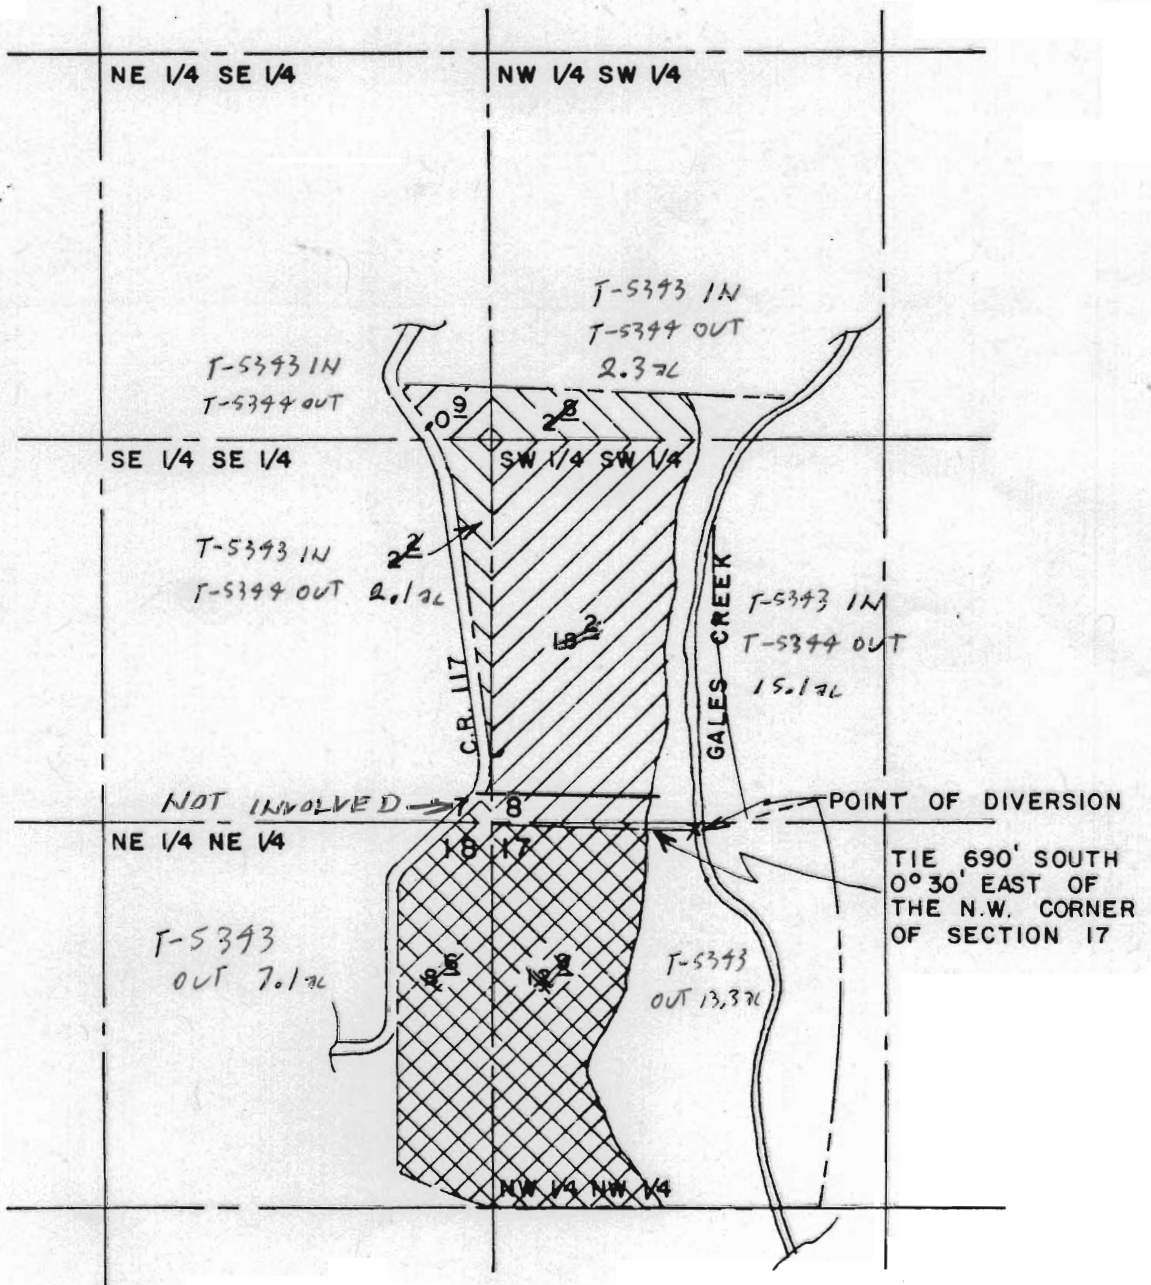

AREA COVERED ON
PREVIOUS APPLICATION