


T. 12S., R. 1W., W. M.

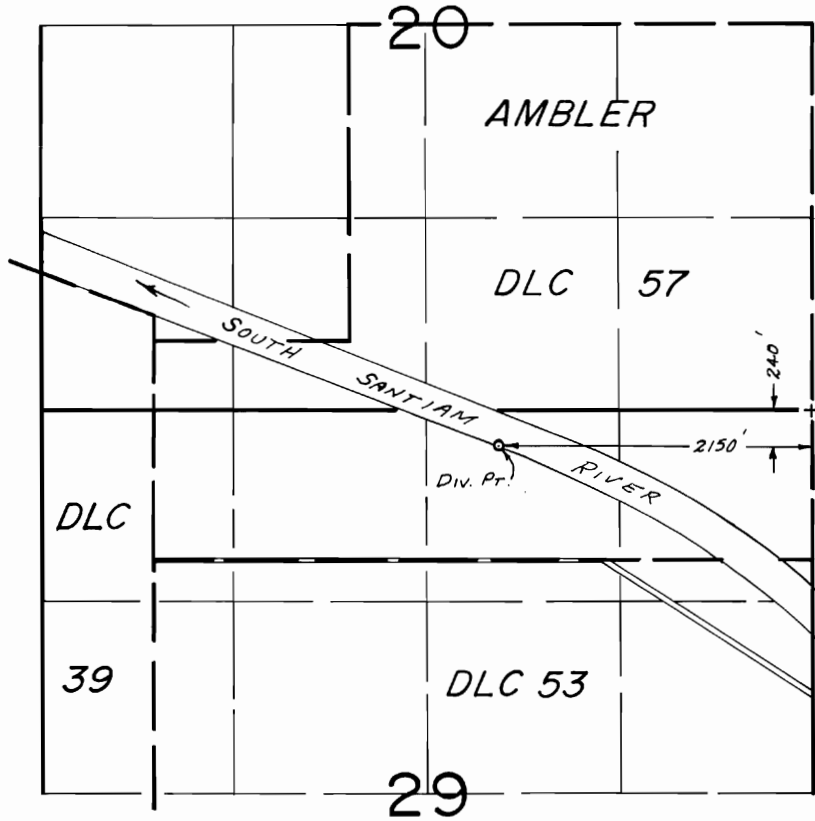

SCALE: 1" = 1320'

FINAL PROOF SURVEY
UNDER

Transfer No. 5354

IN NAME OF

KENNETH RONALD PINKERTON

Surveyed June 7, 1984, by L. M. TOLL