


T. 27 S., R. 2 & 3 W., W. M.

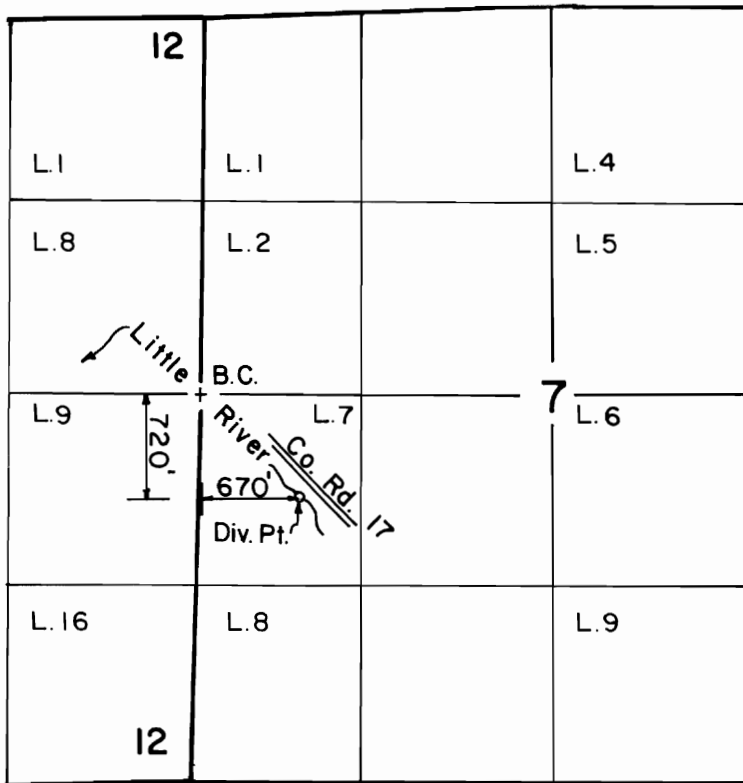

Scale: 1" = 1320'

FINAL PROOF SURVEY
UNDER

TRANSFER NO. 5355

Application No. Permit No.
IN NAME OF

KENNETH & BEATRICE MILLS....

Surveyed OCT. 22, 1991., by B.S. JAMES....