


T-5358

APPLICATION FOR PERMIT
Change in Place of Use

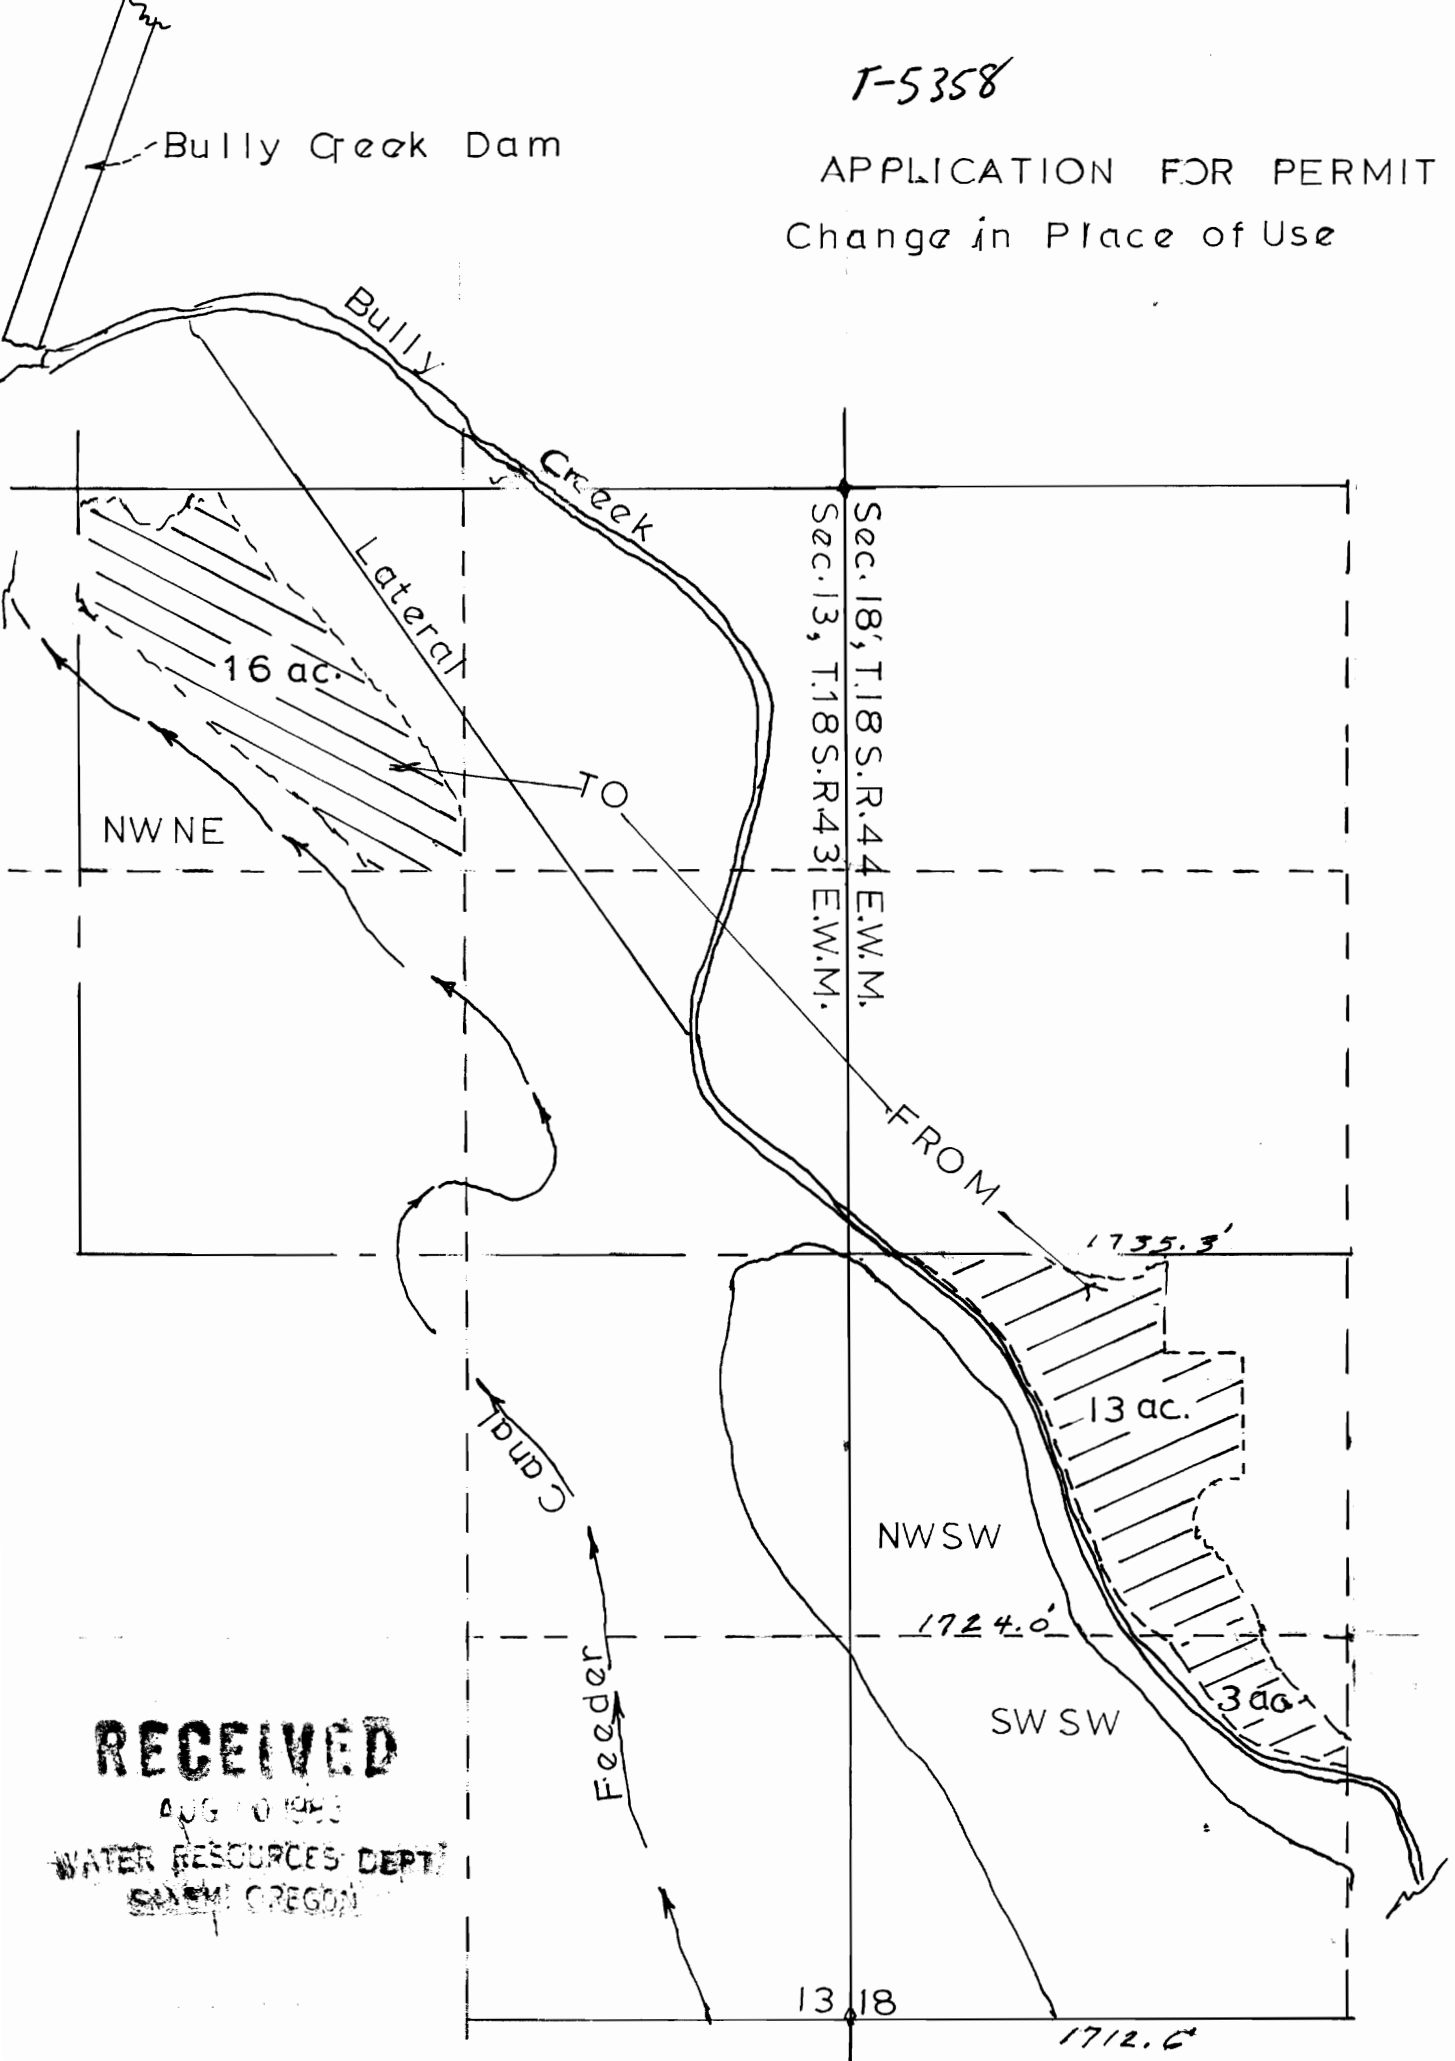

RECEIVED
AUG 10 1953
WATER RESOURCES DEPT
SALEM OREGON