


T.14S.R.9W.W.M.

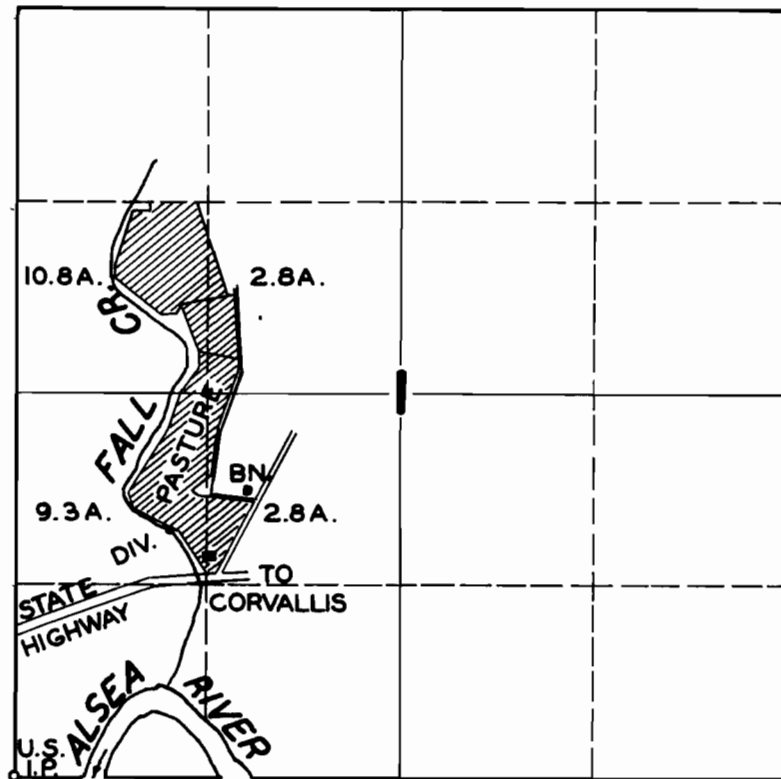

FINAL PROOF SURVEY UNDER

Application No. **19325** Permit No. **14905**
IN NAME OF

RUSSELL K. WOODRUFF

Surveyed **AUG. 4** 1948, by **JAS. E. BUNNELL**