


T. 39 S., R. 3 W., W. M.

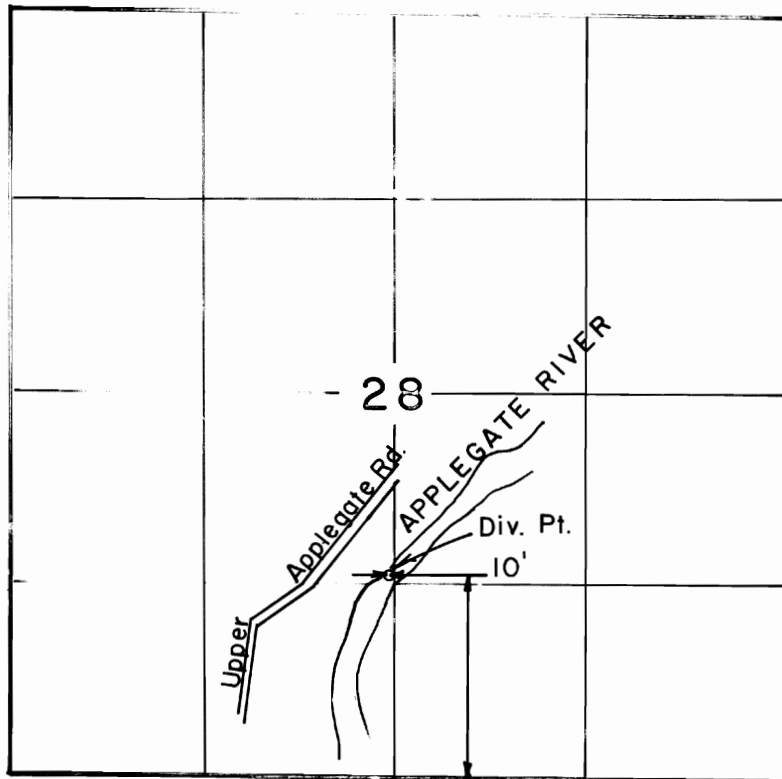

Scale: 1" = 1320'

FINAL PROOF SURVEY
UNDER

TRANSFER NO. 5390
Application No. Permit No.
IN NAME OF

A. H. WEIS & A. A. SPECK

Surveyed JULY 24 1992, by B. S. JAMES...