

SECTION 34 T.16S. R.11E. W.M.

1" = 400'

2.4 OFF (c. 26508, 8/5/1900)


OCT 13 1900

WATER RESOURCES
CLASS OF



27

T-5392

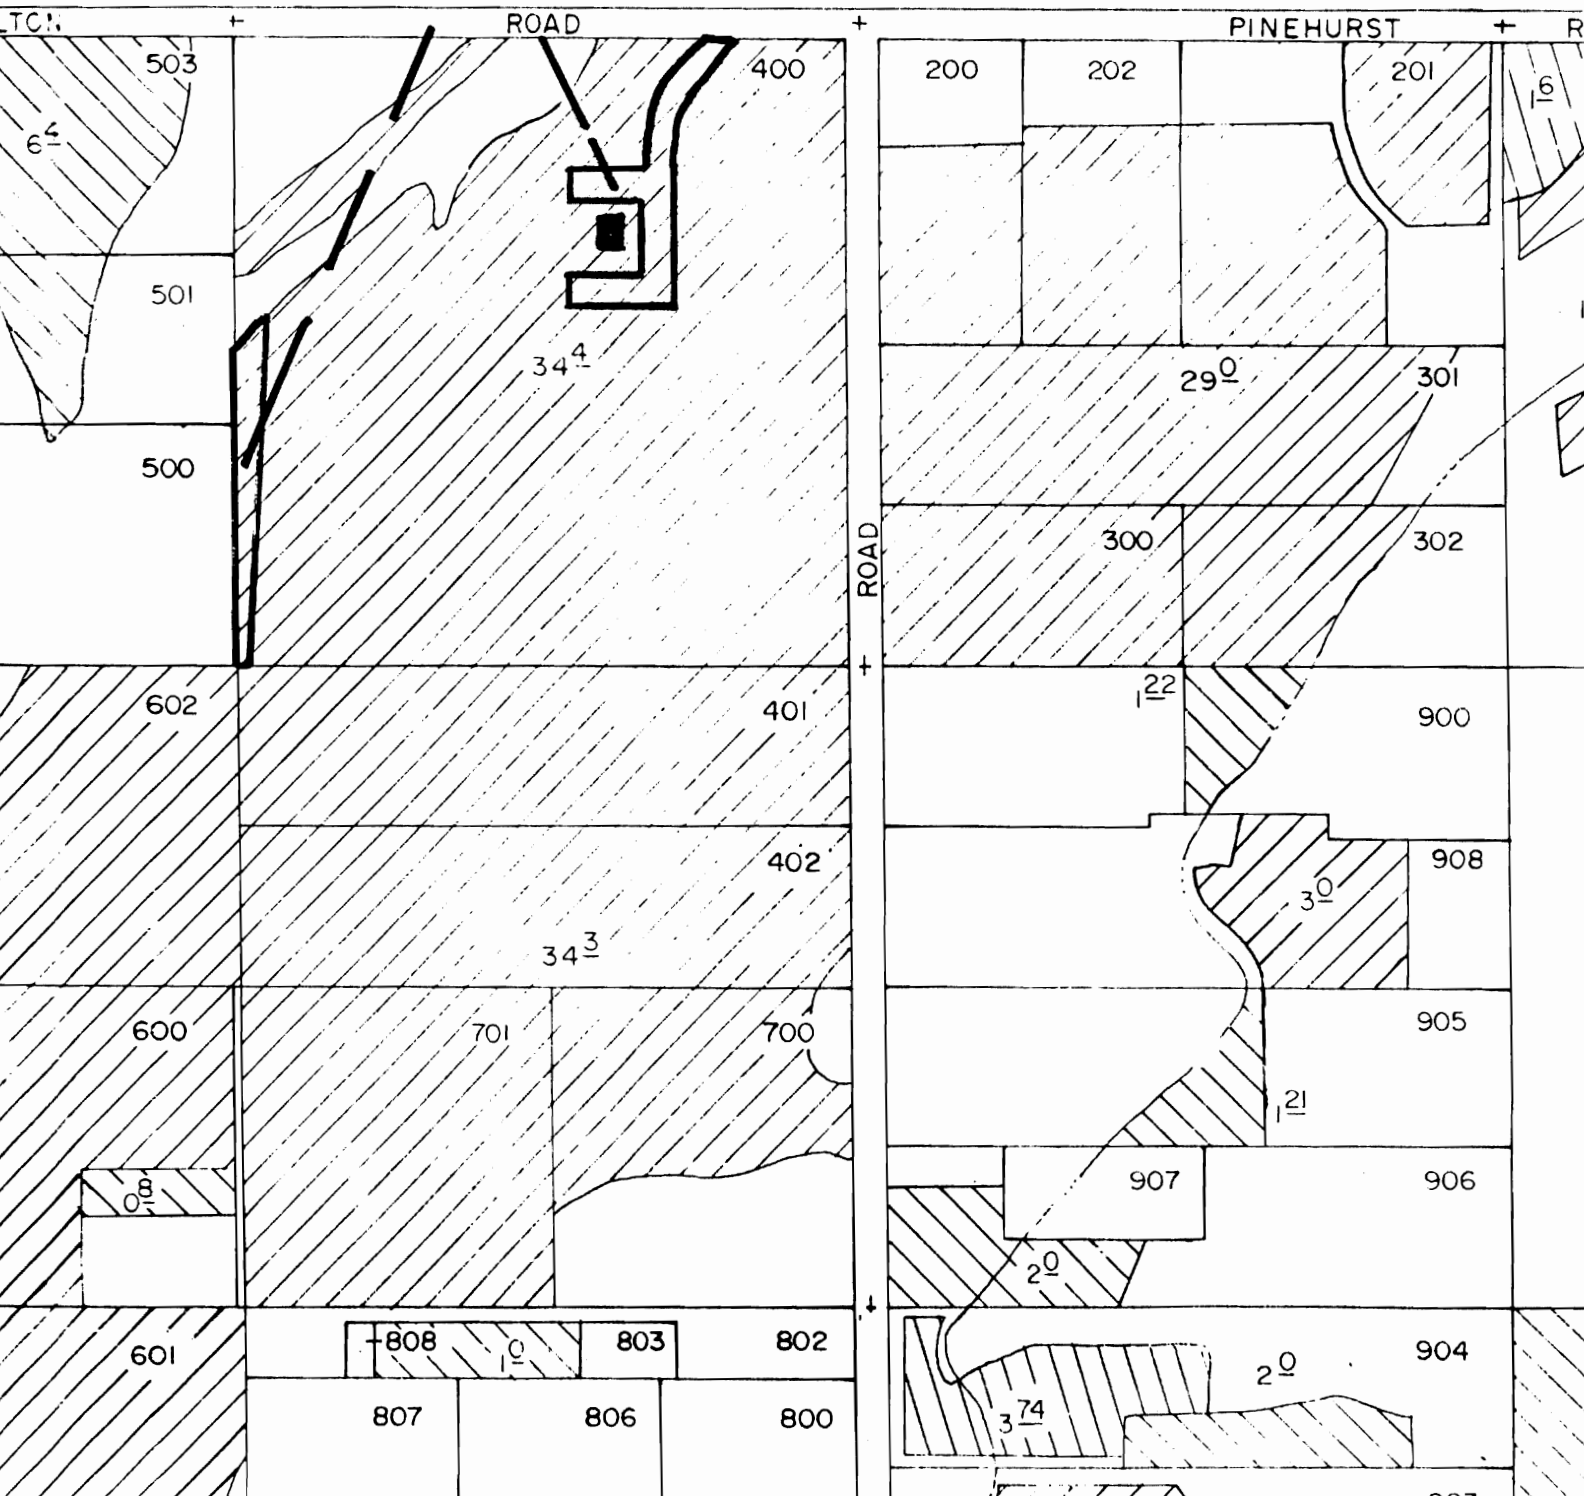

SECTION 27 T.16S. R.11 E. W.M.

1" = 400'

2.4 ON (c. 26508, 8/5/1900)

22

T-5392

RECORDED

OCT 18 1903

WATER RESOURCES
DIVISION OF

