

SECTION 1 T.17S. R.11E. W.M.


1" = 400'

4.0 OFF (c. 26508, 6/1/1907)

OCT 13 1933
WATER RESOURCES
1 OF

36

T-5393

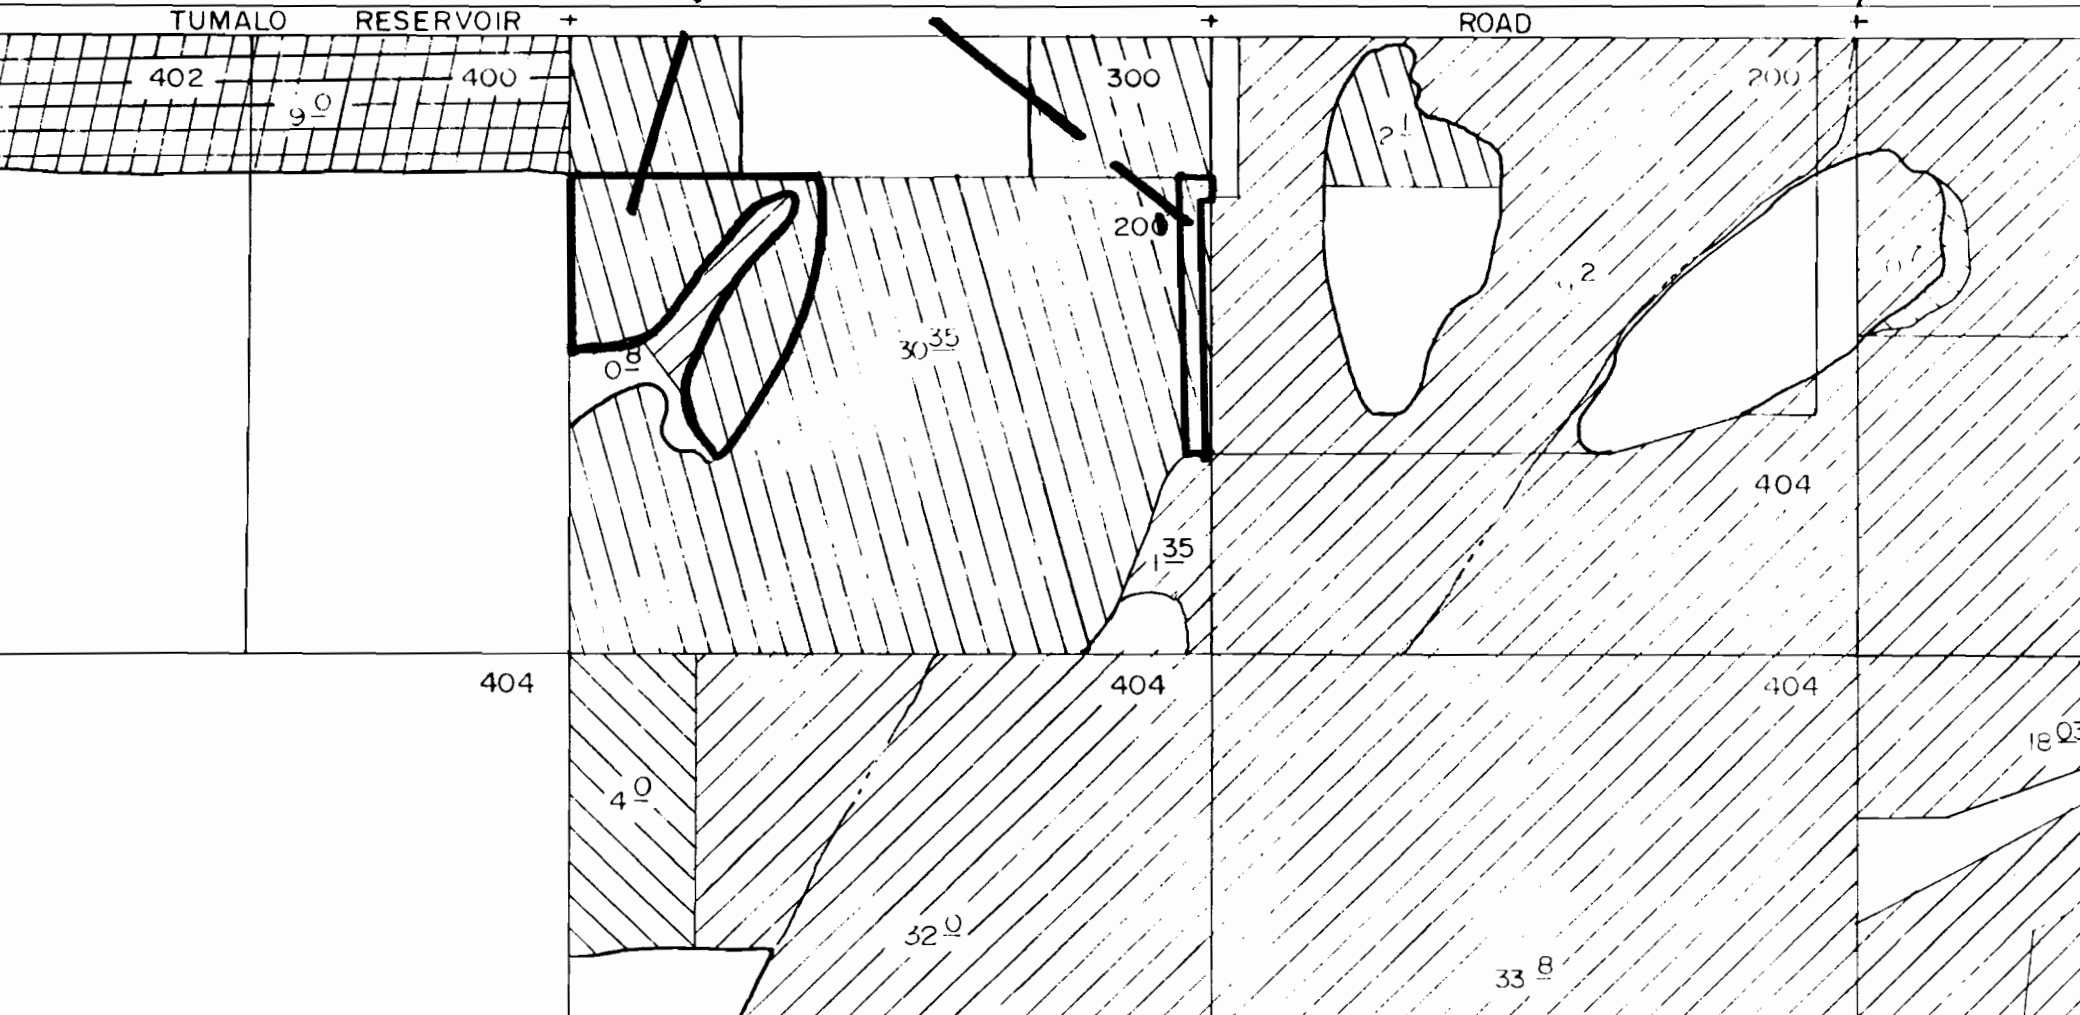

SECTION 34 T.16S. R.11E. W.M.

OCT 13 1930
WATER RESOURCES
1901

1" = 400'

4.0 ON (C. 26508, 6/1/1907)

T-5393

