



# T.13S., R.32E., W.M.

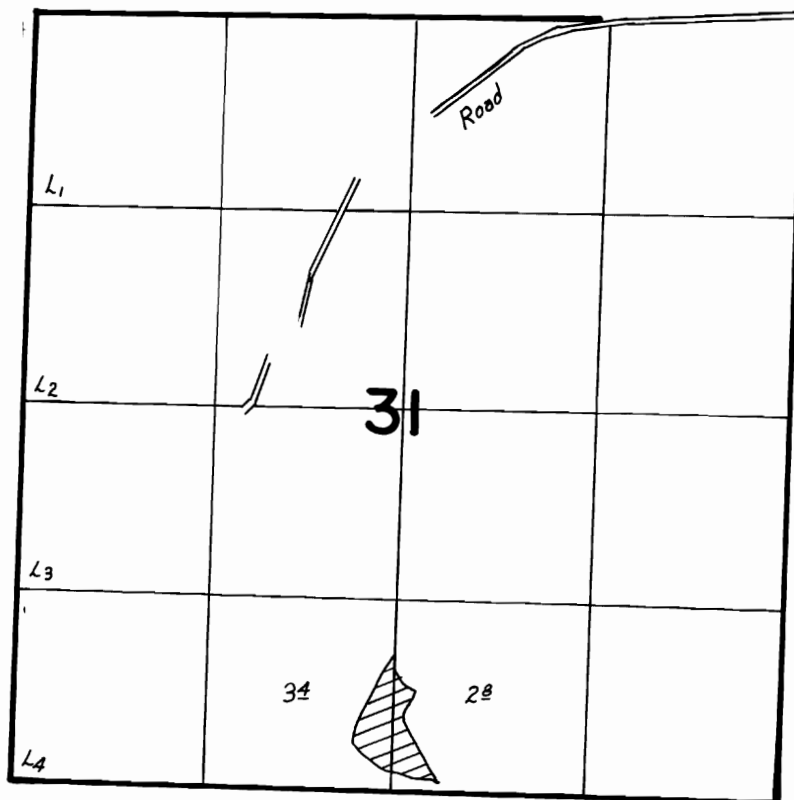

**FINAL PROOF SURVEY**  
UNDER

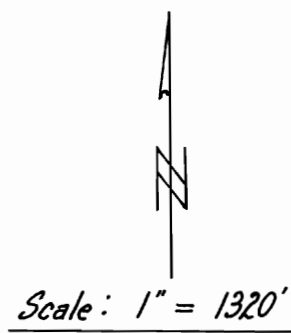

**TRANSFER 5394**

IN NAME OF

...CARL & BETTY...JANE...SHEEDY.....

Surveyed ...7..7..... 19.87., by ..Vern...Church.....