


T. 13 S. R. 31 E. W.M.

Scale 1" = 1320'

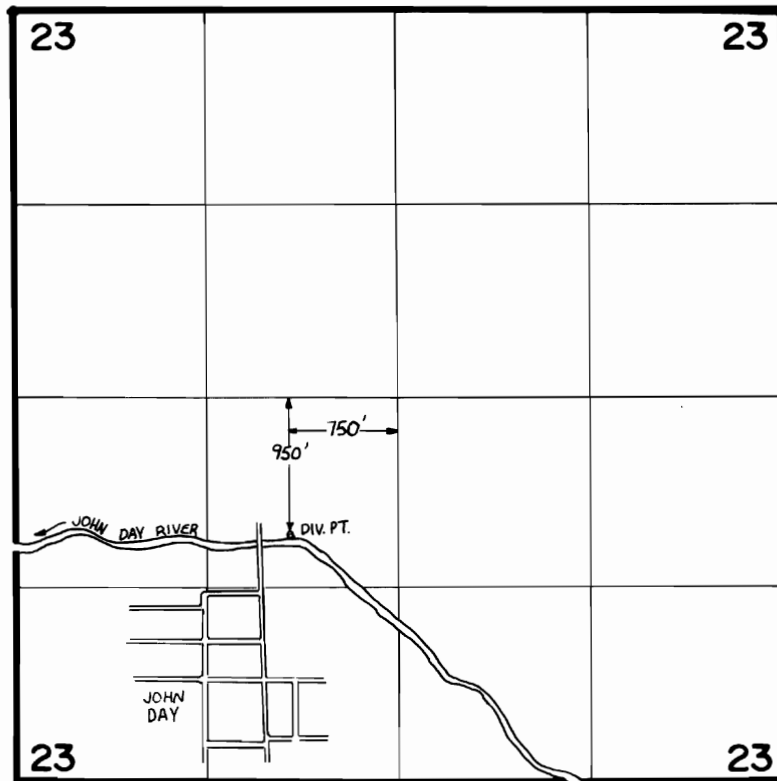

FINAL PROOF SURVEY

UNDER

TRANSFER 5404

IN NAME OF

WM. & JUDITH MARTIN & DONNA ROUND

Surveyed March. 19. 1986., by .X.Church.....