


RECEIVED

JAN 4 1984

WATER RESOURCES DEPT
SALEM, OREGON

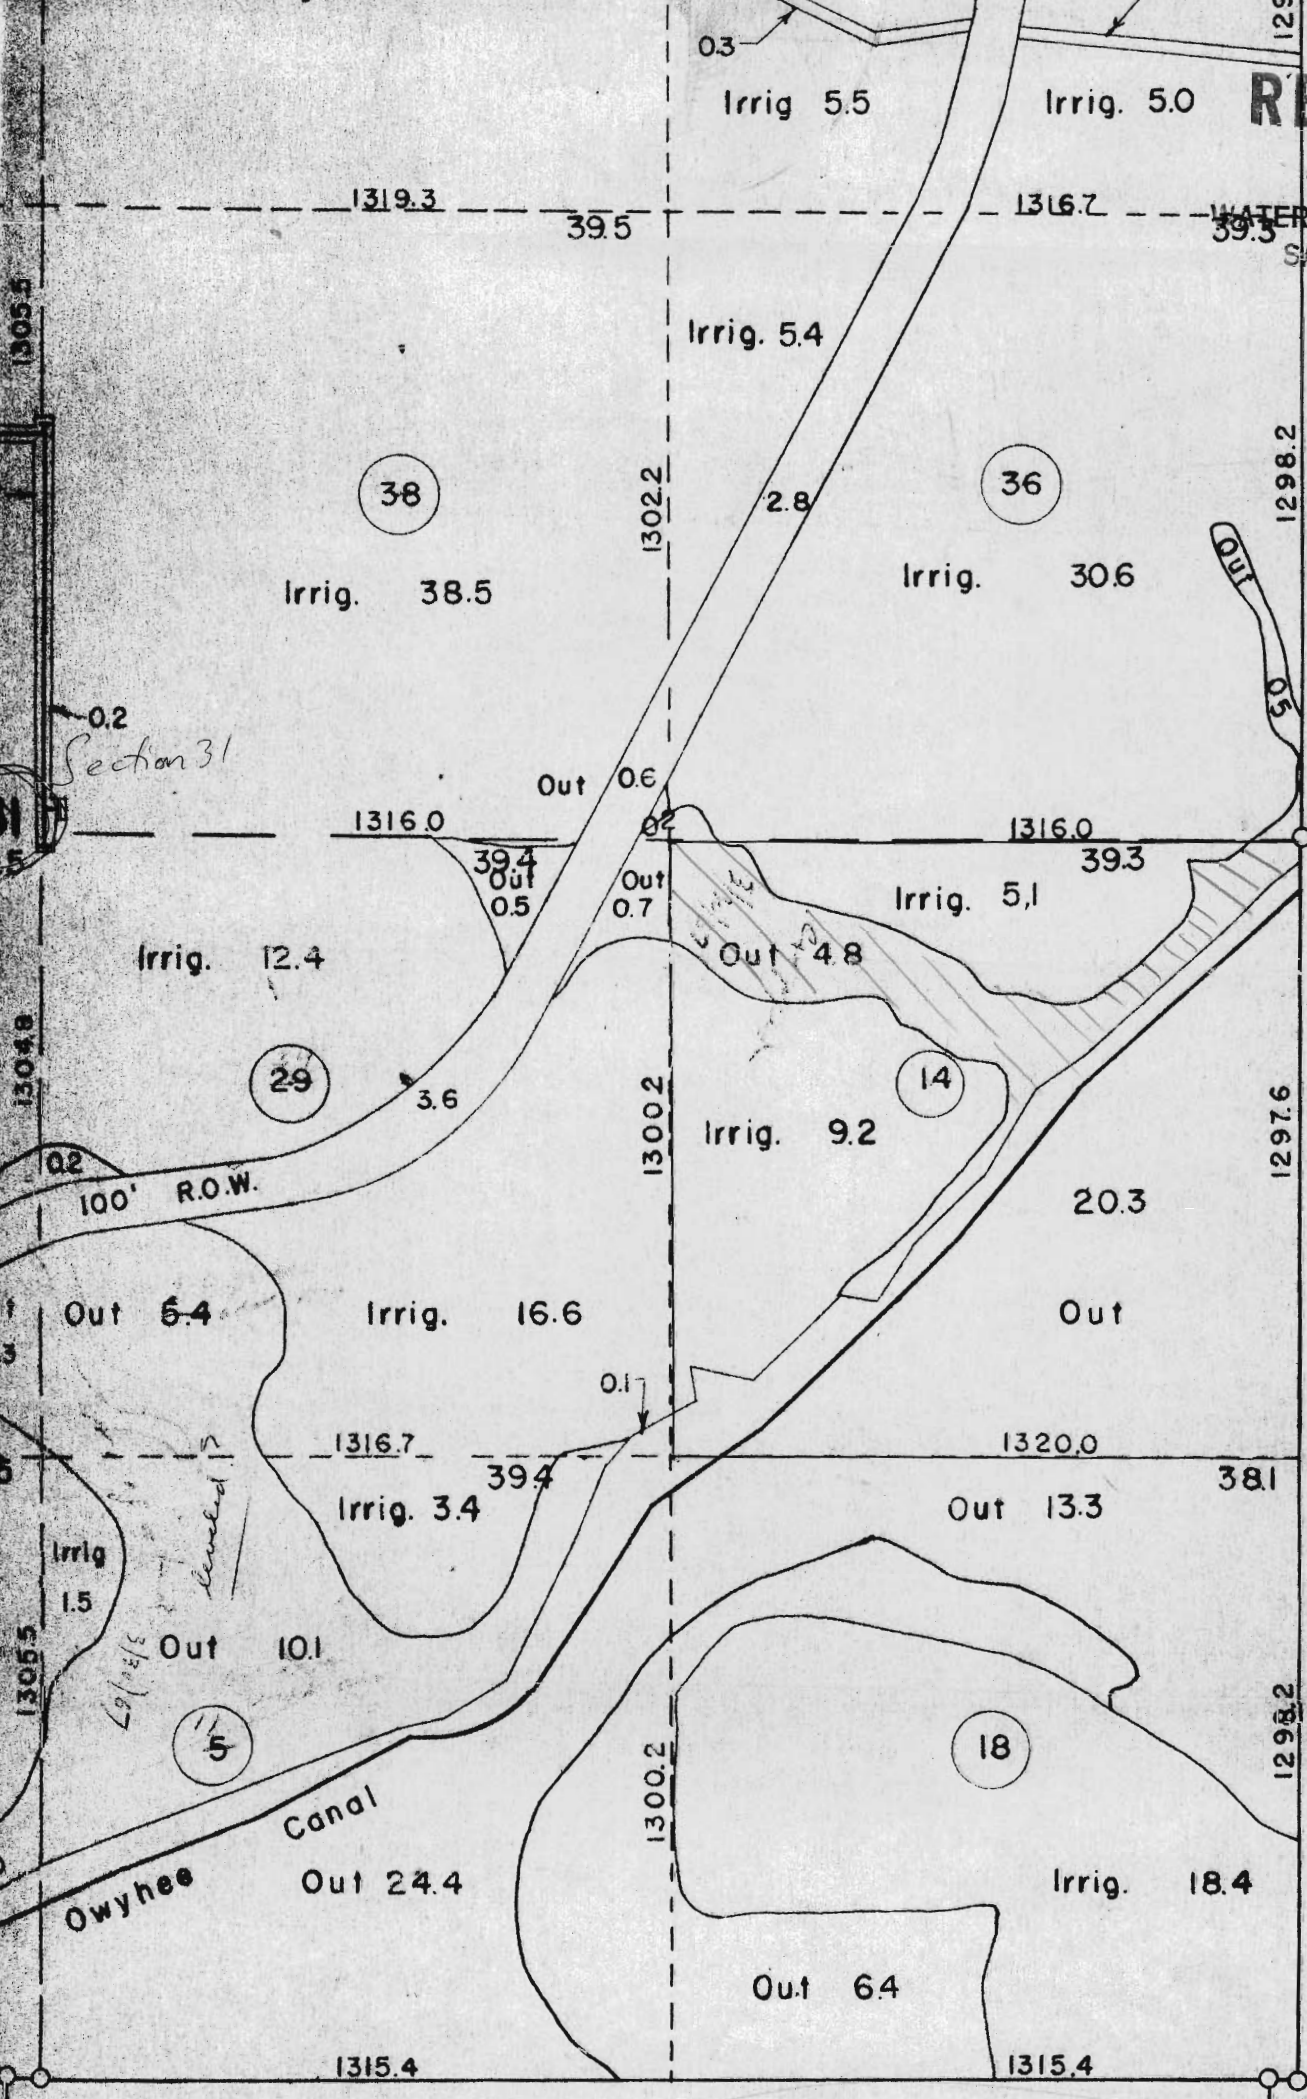

NE 1/4 SE 1/4
Section 31
21.592 Acre
Inclusion

SEC. 31-T.20S.-R.46E