

1317.4
 1317.4
 1315.4
 1315.4
 1310.8
 1310.8
 1316.7
 1316.7
 1316.0
 1316.0
 1311.4
 1311.4
 1310.0
 1310.0

Section 15
 MIDPOINT

SUNY SEW Section 15
 T.20S R.46E, WM.
 J.E. Brewer
 Inclusion 9.752 Acres

Out 8.9
 9.0 A
 Inclusion from
 address
 1930


RECEIVED

DEC 18 1983

WATER RESOURCES DEPT.
 SALEM, OREGON

T-5425

SEC. 15 - T

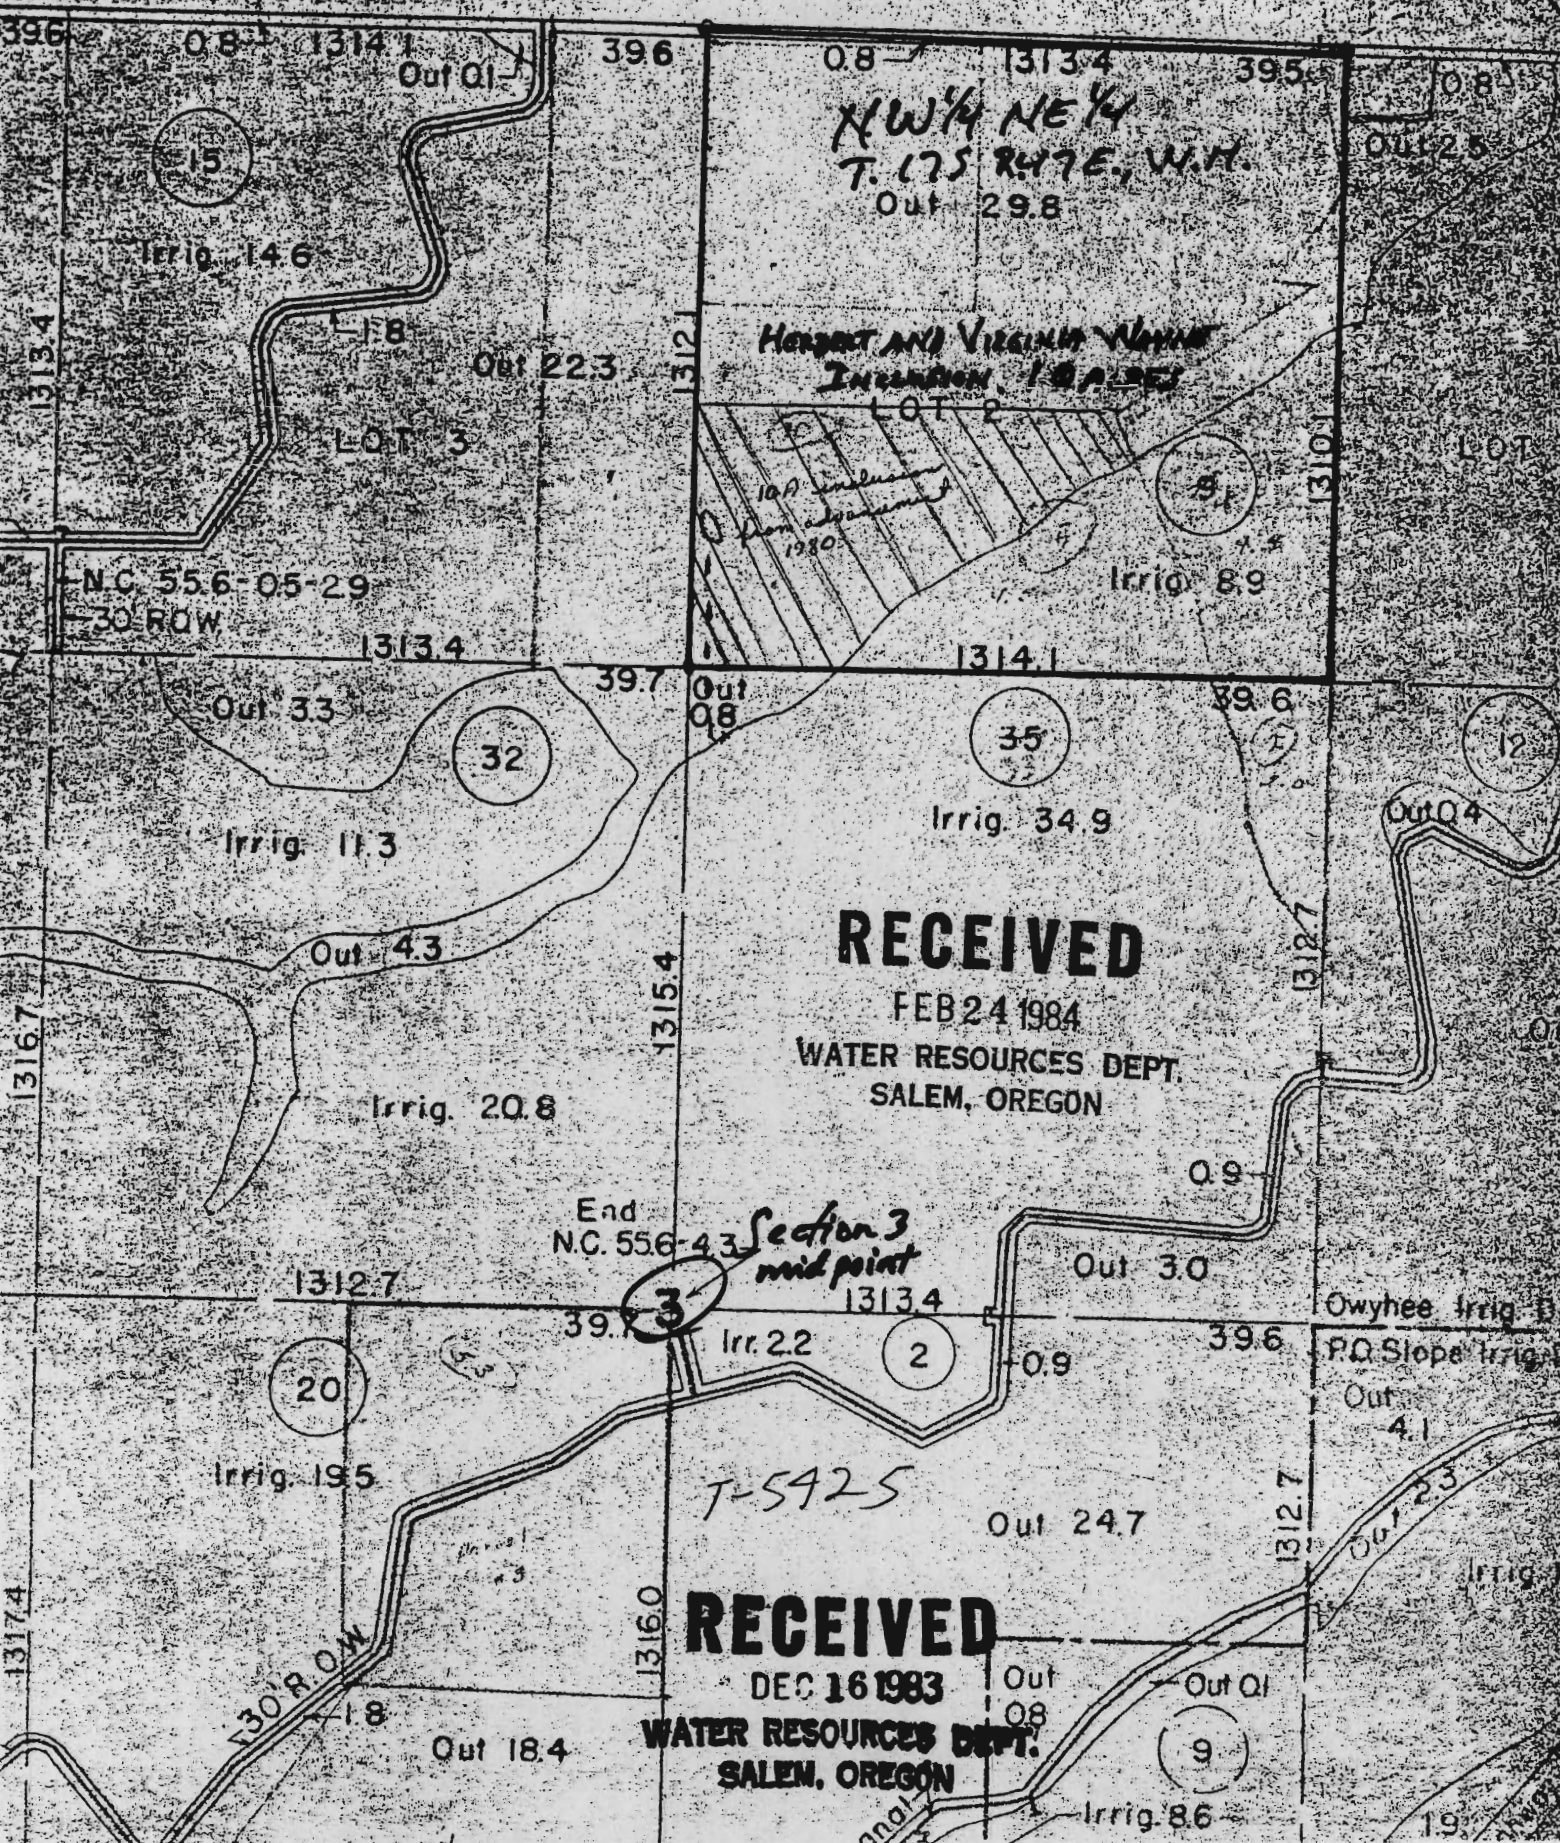

NW 1/4 NE 1/4
T. 175 R. 47 E., W.M.
Out 29.8

Hazel and Virginia Woods
Inclusion 1980

100 Inclusion
from document
1980

RECEIVED

FEB 24 1984
WATER RESOURCES DEPT.
SALEM, OREGON

Section 3
mid point

T-5925

RECEIVED

DEC 16 1983
WATER RESOURCES DEPT.
SALEM, OREGON



15

LOT 3

LOT 2

LOT

Out 3.3

32

35

12

Irrig. 11.3

Irrig. 34.9

Out 0.4

Out 4.3

Irrig. 20.8

End
N.C. 556-43

3

Irr. 2.2

2

Out 3.0

Owyhee Irrig. D

P.O. Slope Irrig.

Out 4.1

Irrig. 19.5

20

Out 24.7

Out 2.3

130' R.O.W.

Out 18.4

Out 0.8

9

Irrig. 8.6

19