


T. 2N., R. 13E., W.M.

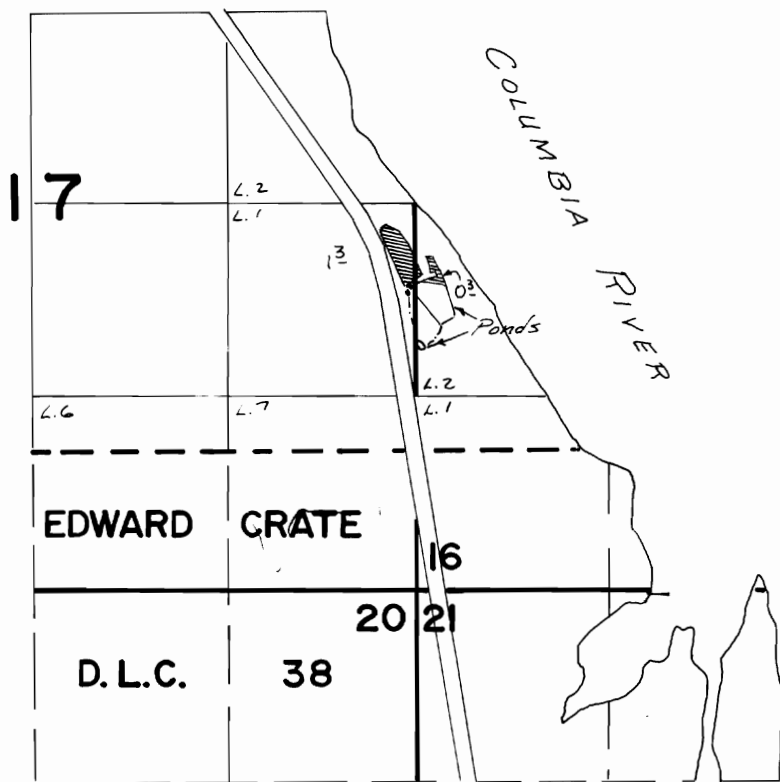

SCALE 1" = 1320'

**FINAL PROOF SURVEY**  
UNDER

**TRANSFER 5429**  
IN NAME OF

**DALE W. JONES**

Surveyed 11:17..... 1987, by V.L. Church.....