

T-5433

JAN 8 1994
 WATER RESOURCES DEPT.
 SALEM, OREGON

RECEIVED

T 9 S, R 13 W, WM
 Scale 1" = 1320'

T 9 S, R 3 E 4 W, 60 M
Scale 1" = 1320'


T-5433

JOHN D. WOOD D.L.C. 44

JOSEPH POLLY D.L.C. 44



TRANSFERRED FROM

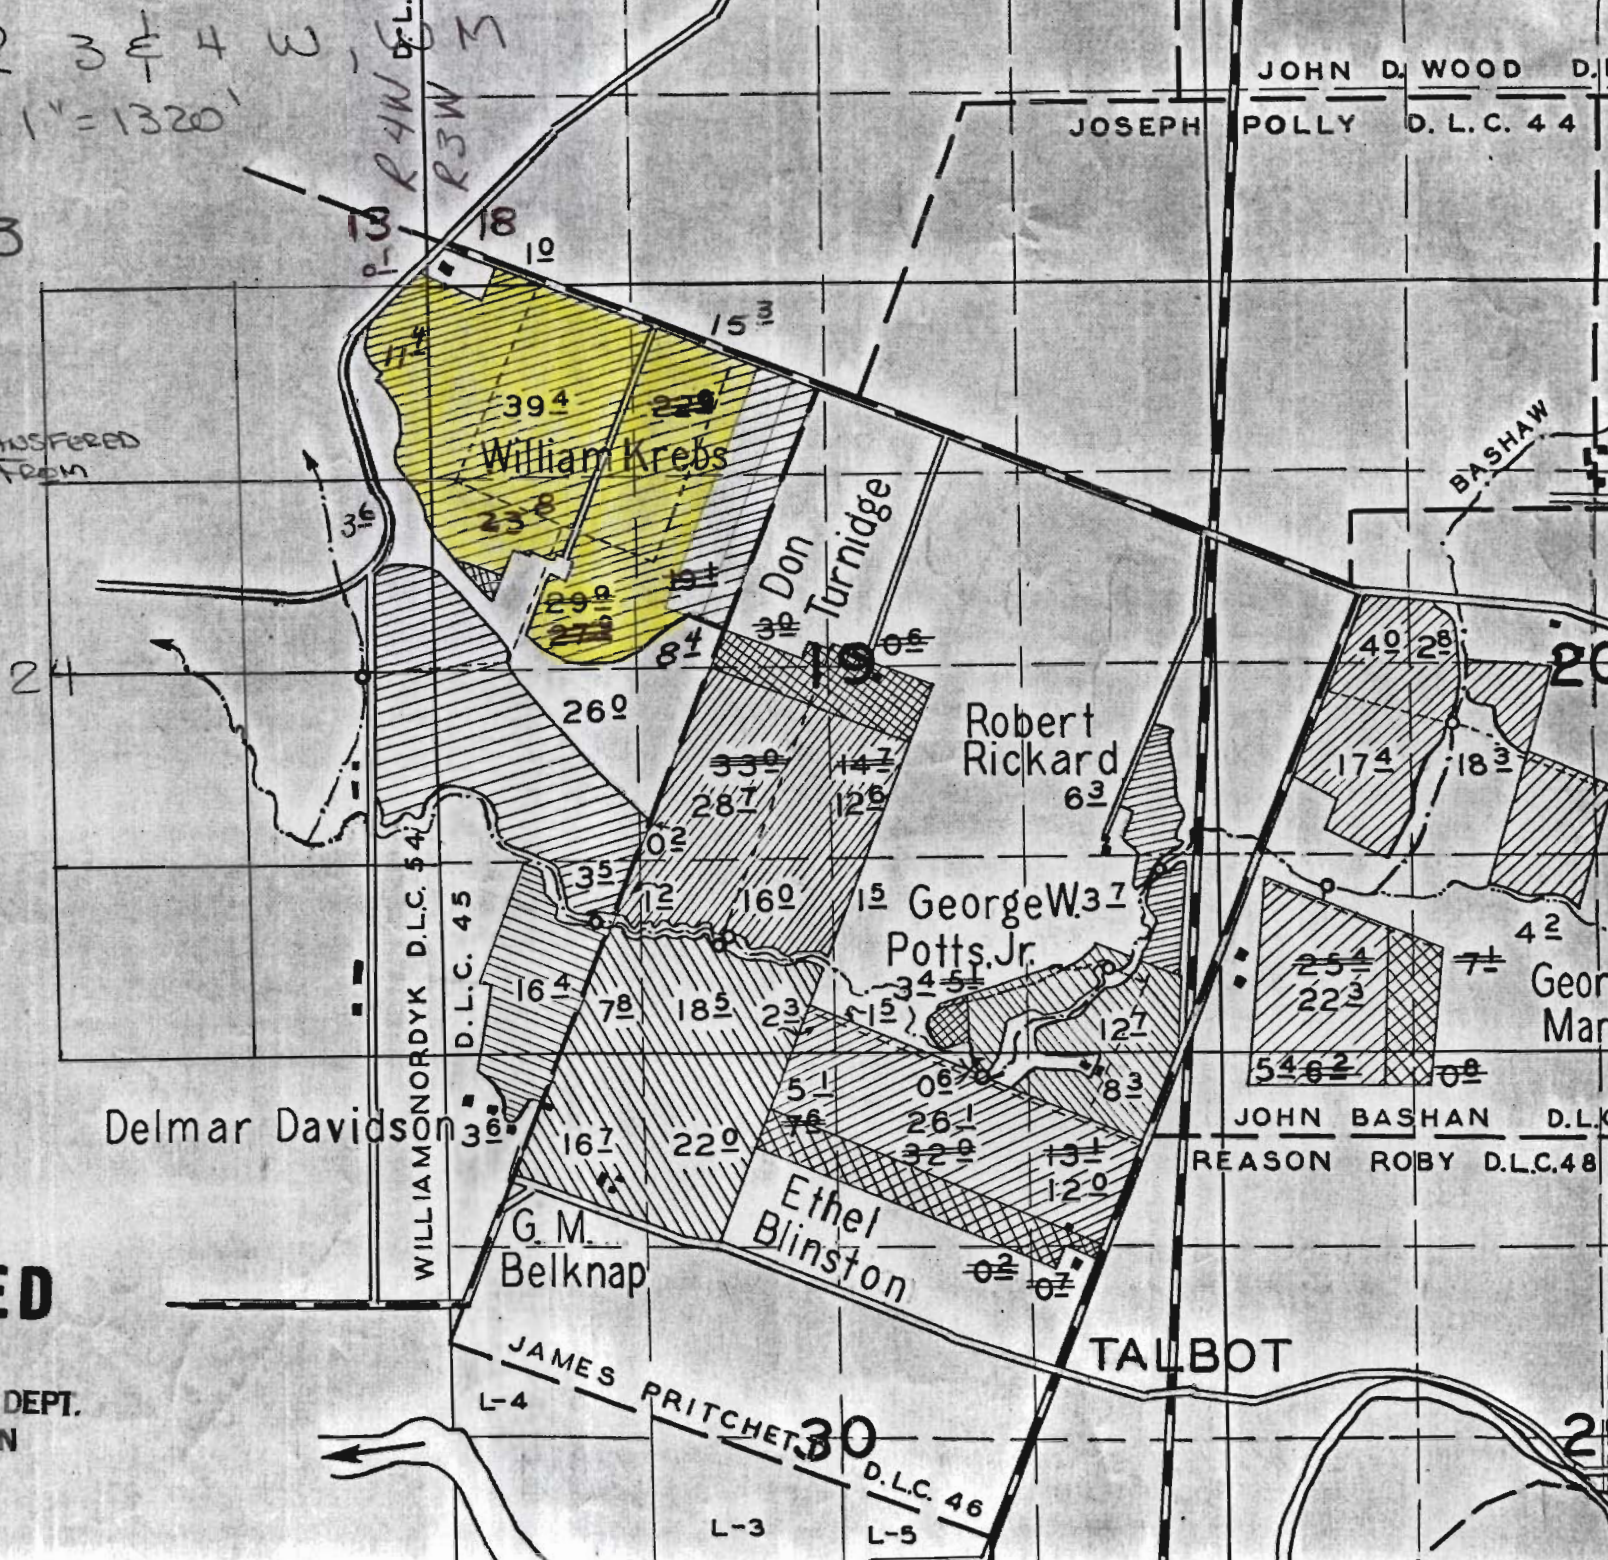

BASHAW

Delmar Davidson

WILLIAM NORDYK D.L.C. 54
D.L.C. 45

G.M. Belknap

Ethel Blinston

JAMES PRITCHETT D.L.C. 46

Robert Rickard

George W. Potts, Jr.

JOHN BASHAN D.L.C. 48
REASON ROBY D.L.C. 48

TALBOT

RECEIVED

JAN 2 1924
WATER RESOURCES DEPT.
SALEM, OREGON

L-3

L-5

2

TYJOHN

DLC 39

16

16

T-5433



- TRANSFERRED
"TO"

T 9 S, R 3 W, WM
Scale 1" = 1320'

ANKENY NATIONAL
WILDLIFE REFUGE

HARRIS

RECEIVED

JAN 8 1984

WATER RESOURCES DEPT.
SALEM, OREGON

F. GILMOUR

ANDERSON

DLC 50

16

16

21

22

ANKENY NATIONAL
WILDLIFE REFUGE

HELM DLC 51

EBERHARDT

CARRIG

VAN LOON

