
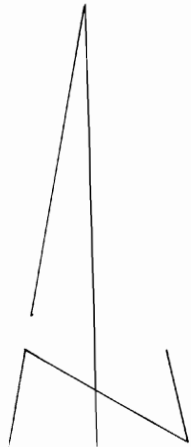


T. 20S., R. 36E., W.M.

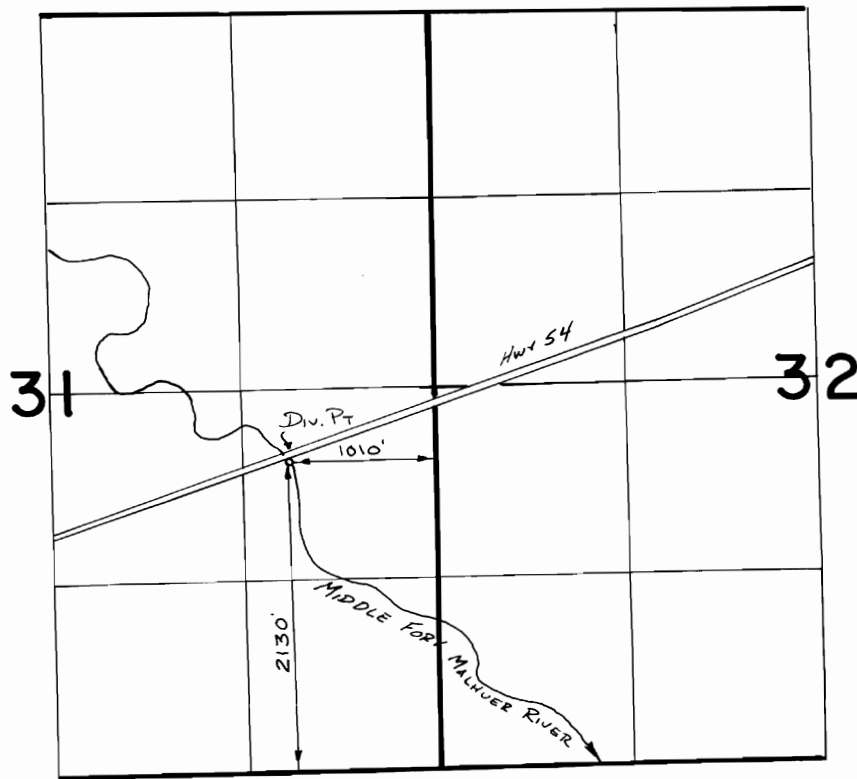

SCALE 1" = 1320'

**FINAL PROOF SURVEY**  
UNDER

**TRANSFER 5436**  
IN NAME OF

**WILLIAM R. ROBERTSON**

Surveyed 5-9 1988, by B.S. James