


T. 38 S., R. 5 W., W. M.

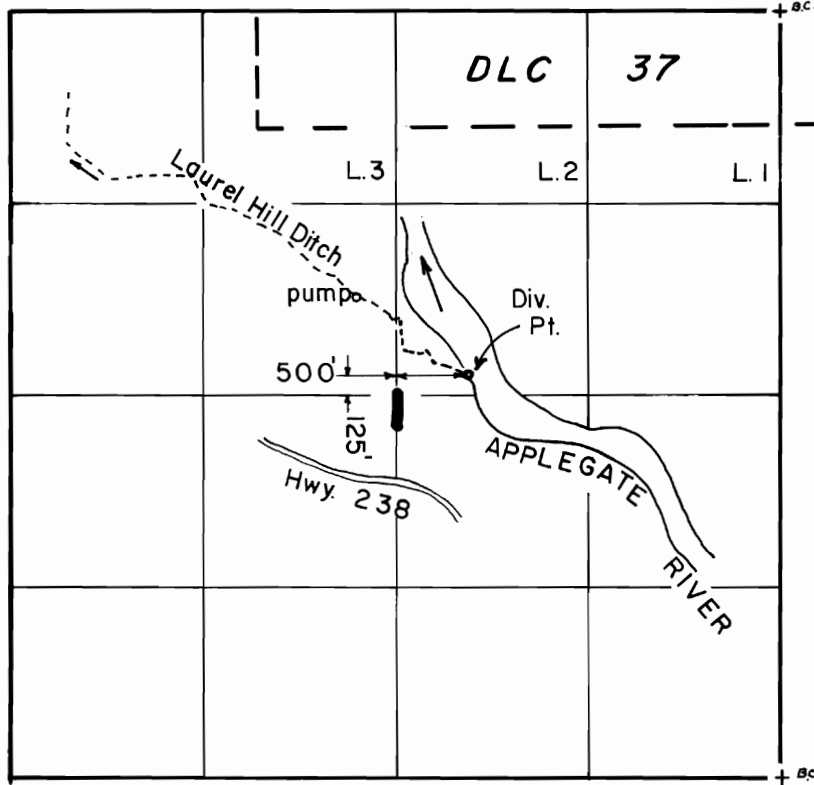

Scale: 1" = 1320'

FINAL PROOF SURVEY UNDER

TRANSFER NO. 5455

Application No. Permit No.

IN NAME OF

..... USDI - BLM

Surveyed NOV. 22. 1989, by B. S. JAMES...