

RECEIVED


MAR 30 1984


WATER RESOURCES DEPT.
SALEM, OREGON

T-5460

SECTION 10
T. 20 S
R. 45 E, WM

SECTION
MIDPOINT

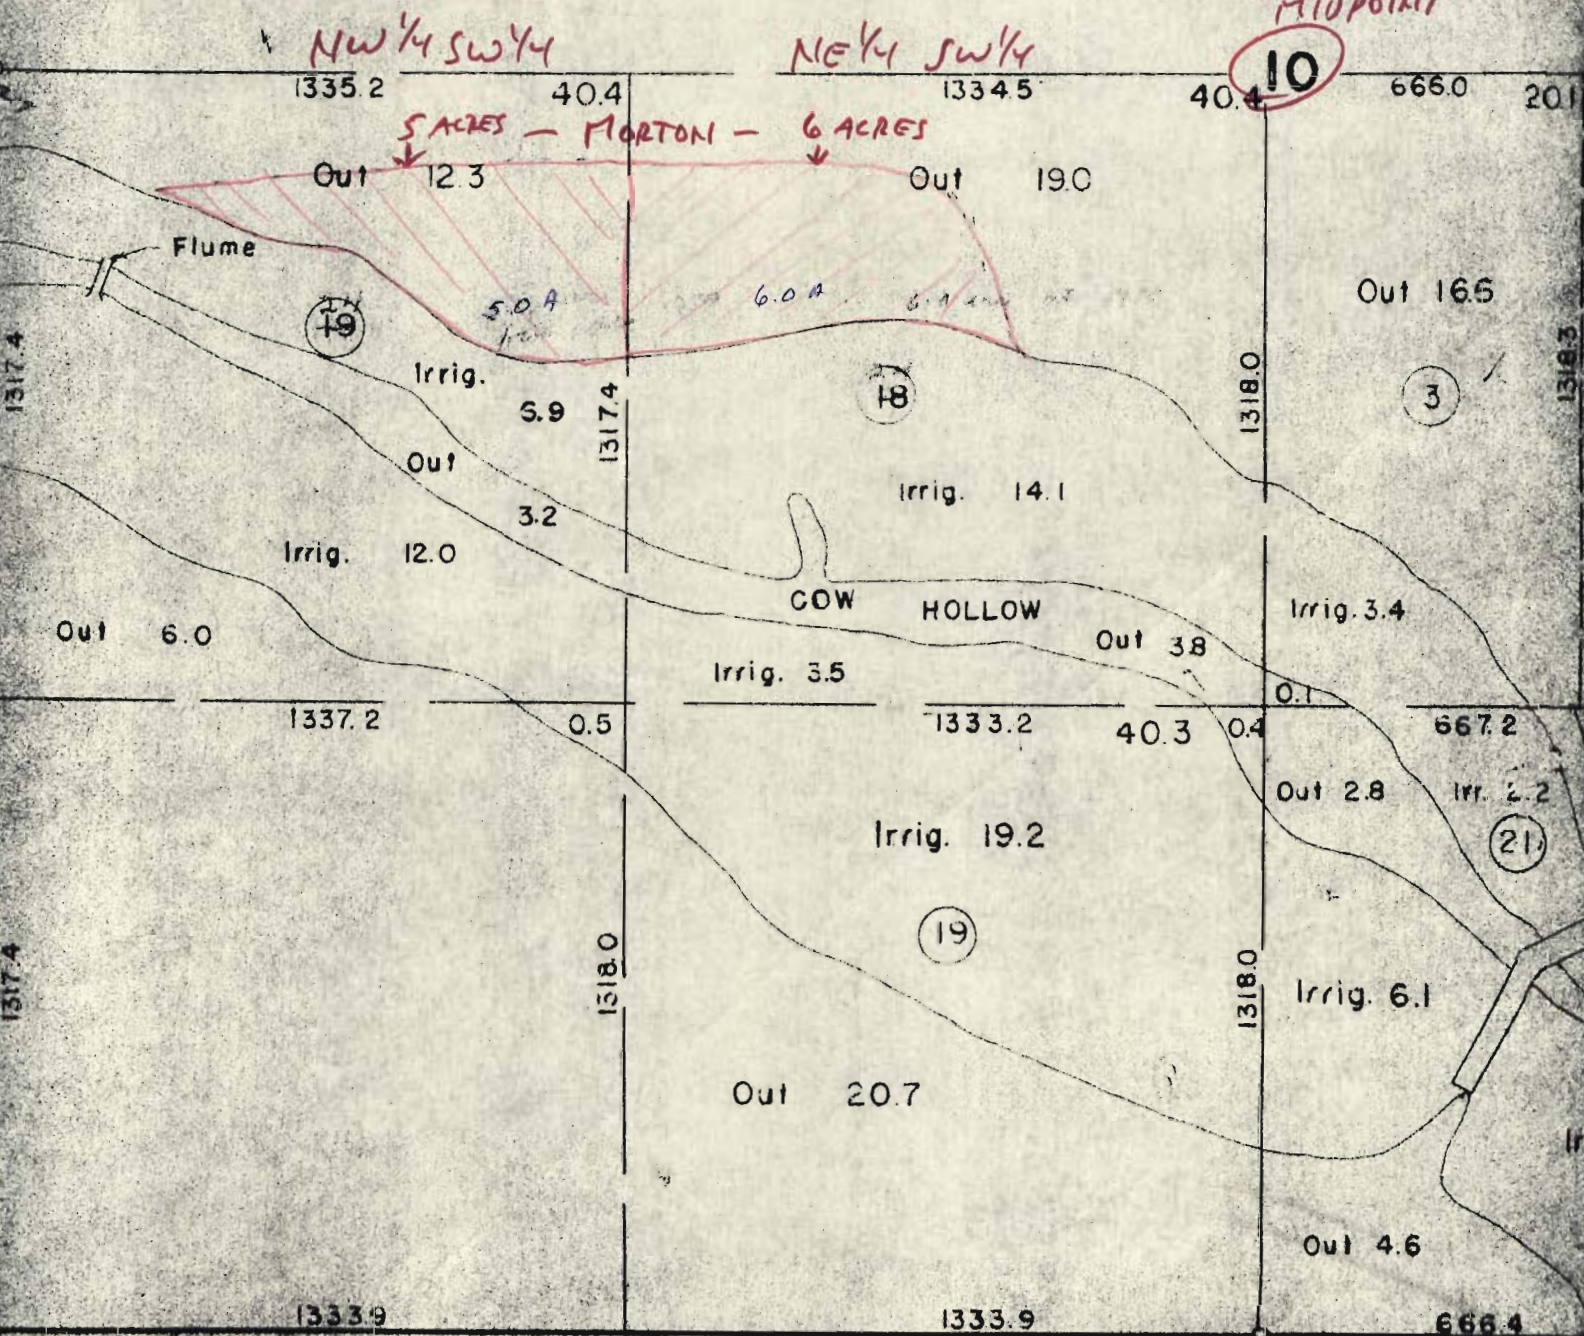

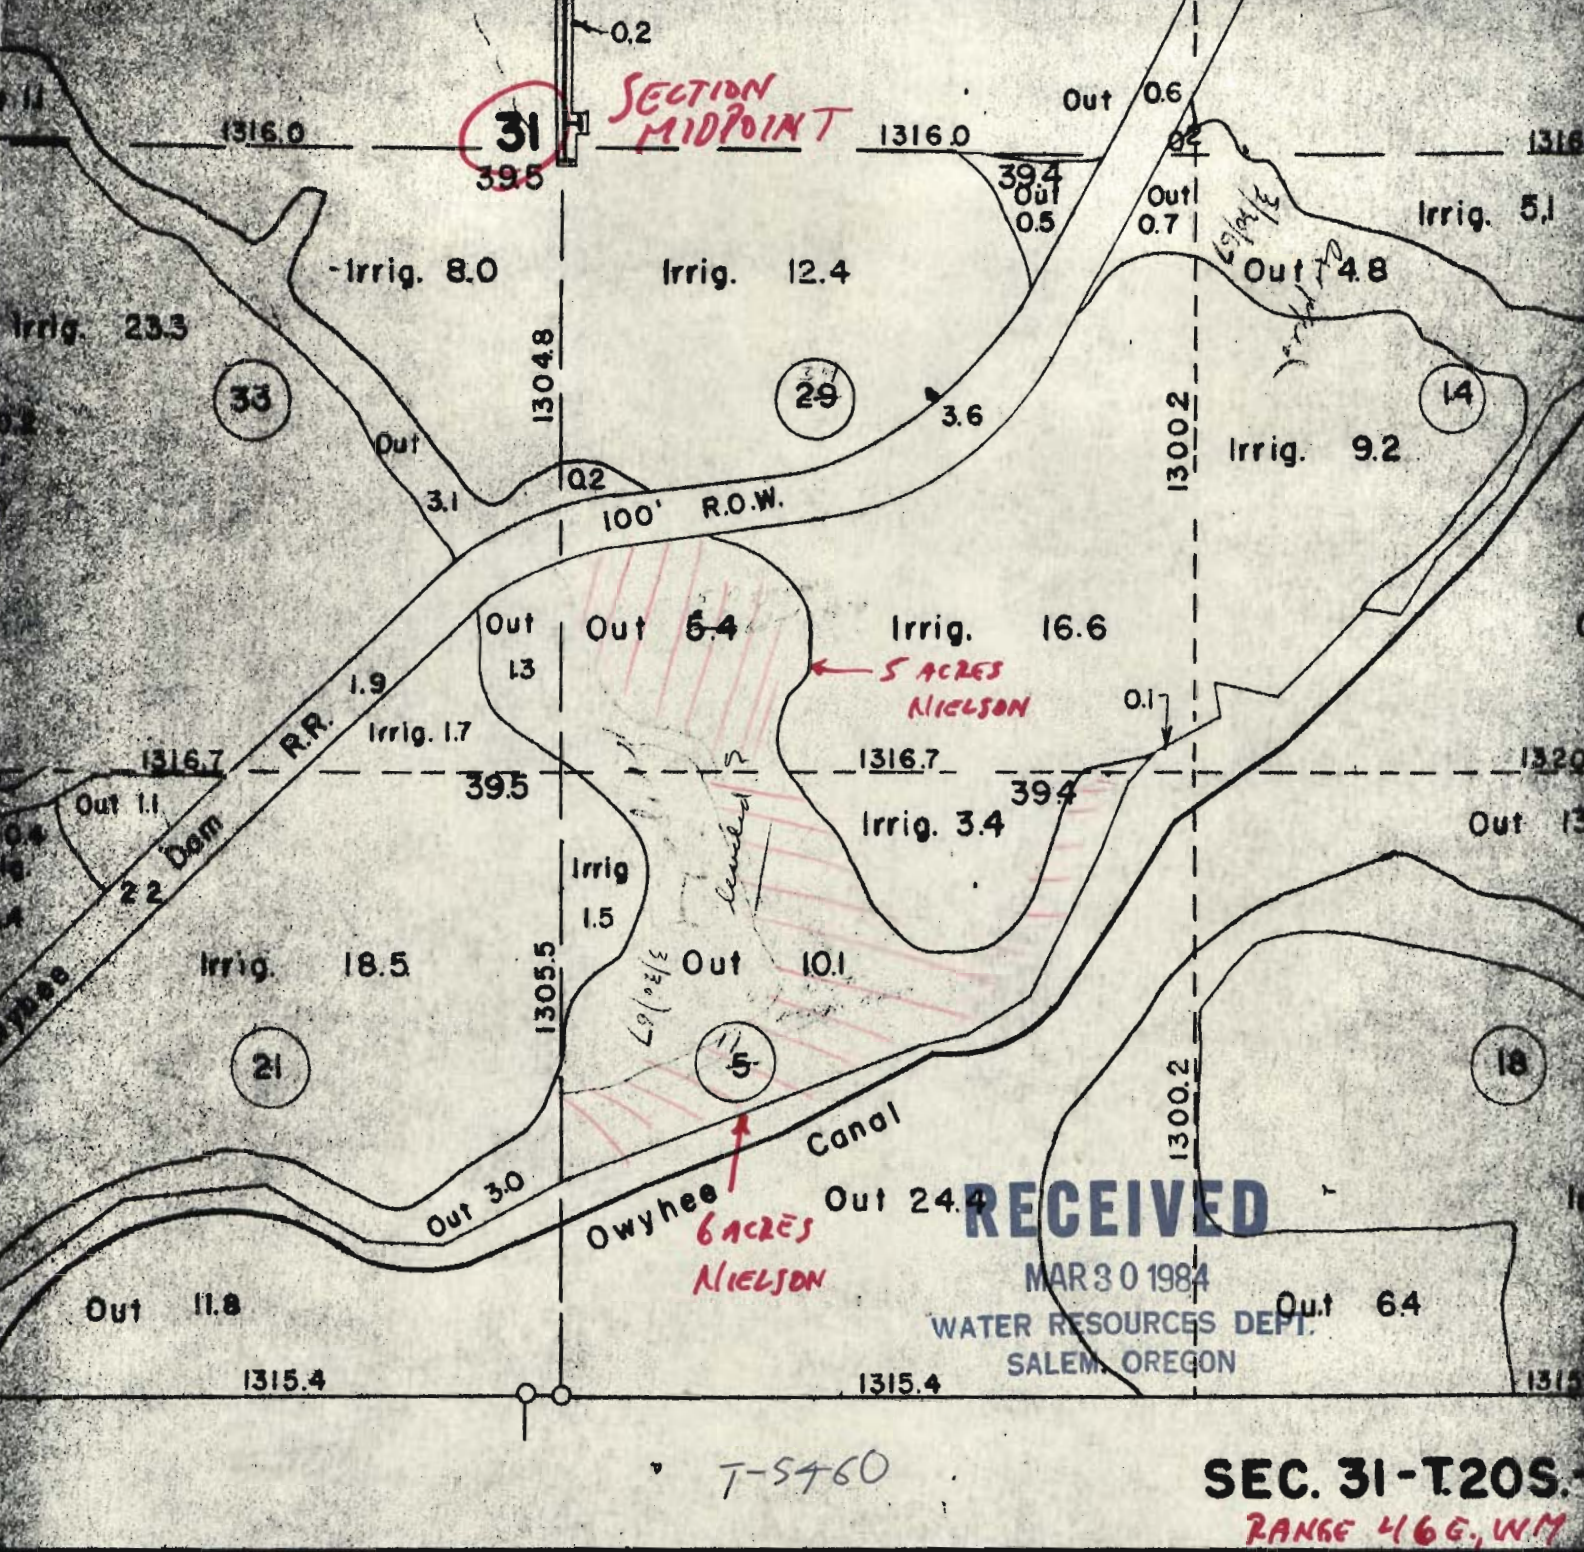

31

SECTION
MIDPOINT

5 ACRES
NIELSON

6 ACRES
NIELSON

RECEIVED

MAR 30 1984

WATER RESOURCES DEPT.
SALEM, OREGON

T-5460

SEC. 31-T20S.

RANGE 46E, WM


RECEIVED

MAR -9 1987

WATER RESOURCES DEPT.
SALEM, OREGON

INCLUSION MAP

T-5960

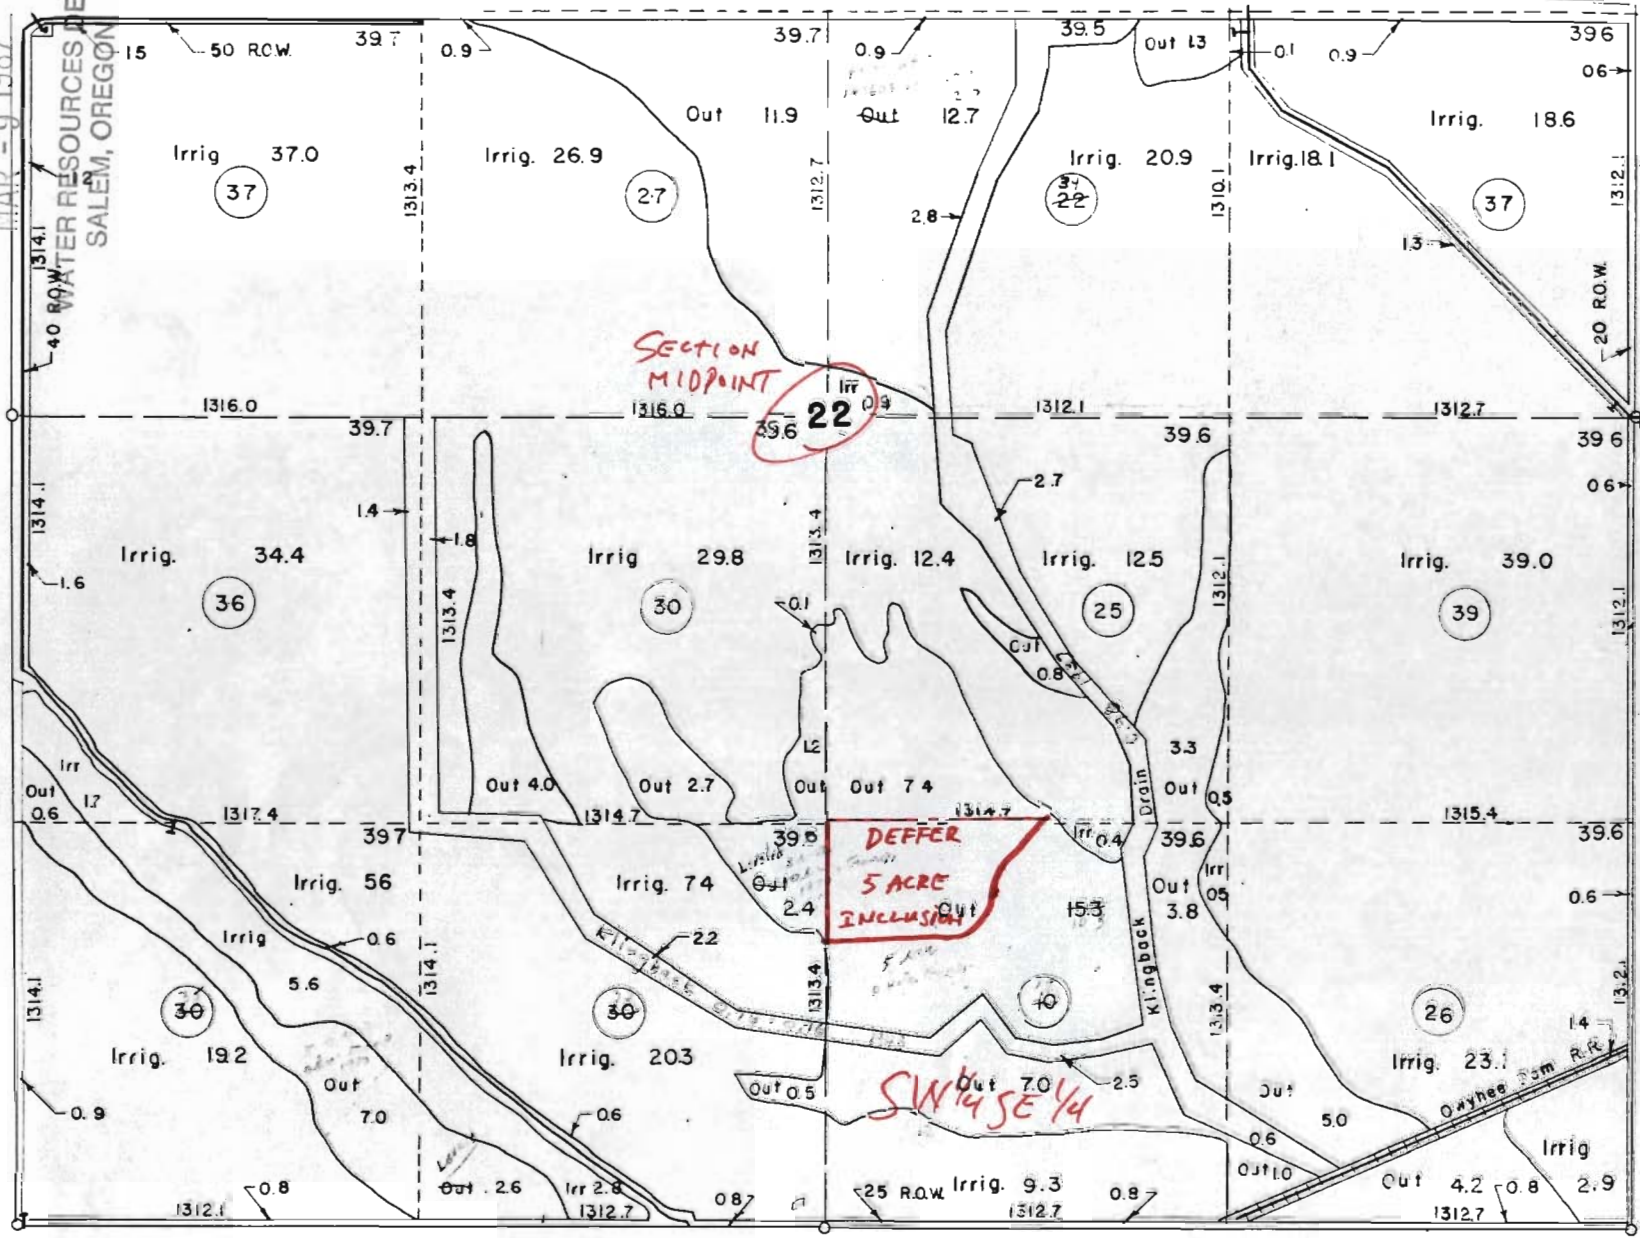

SEC. 22 - T.20S. - R.46E.

Traced: J.H. 4/12/57
Checked M.Y. 5/10/57

RECEIVED


T. 205
R. 416 E., W.M.

MAR 30 1984

WATER RESOURCES DEPT.
SALEM, OREGON

SECTION
MIDPOINT

22

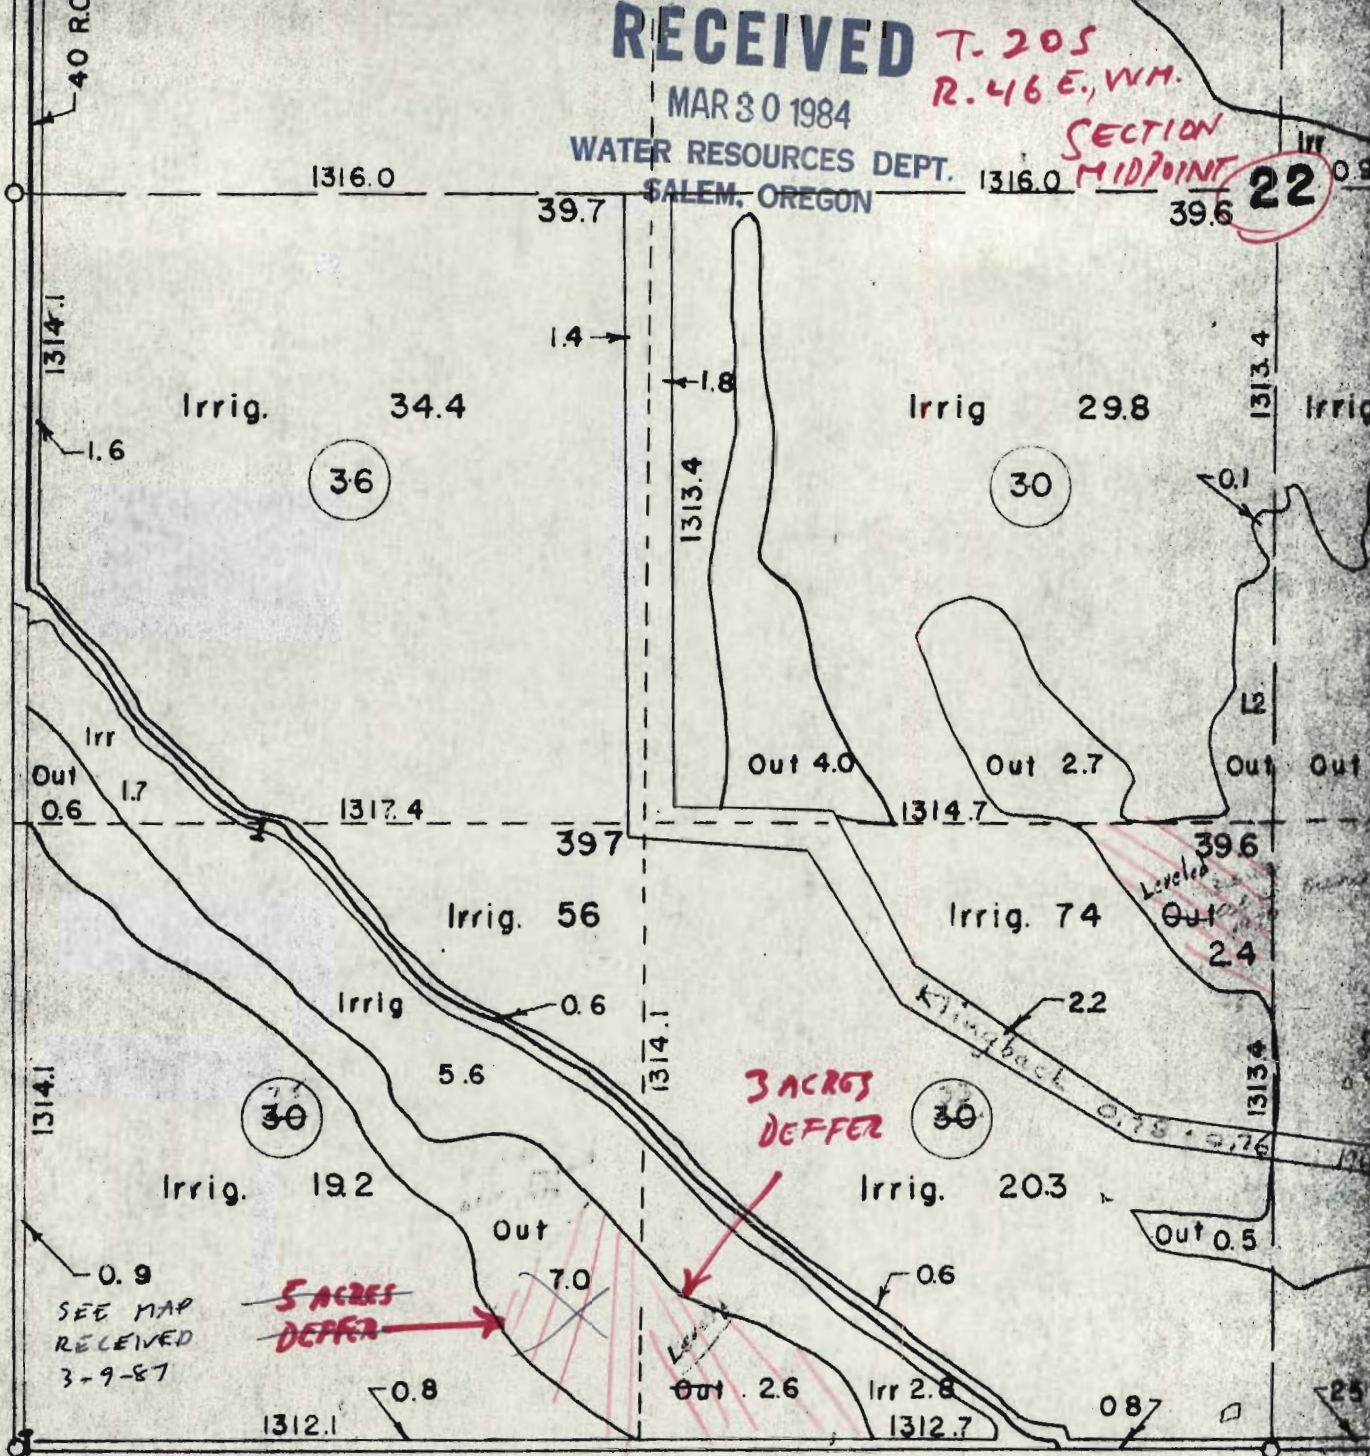

T-5460


Traced: J.H. 4/12/57


Checked M.Y. 5/10/57

RECEIVED

MAR 30 1984
WATER RESOURCES DEPT.
SALEM, OREGON

T-5460

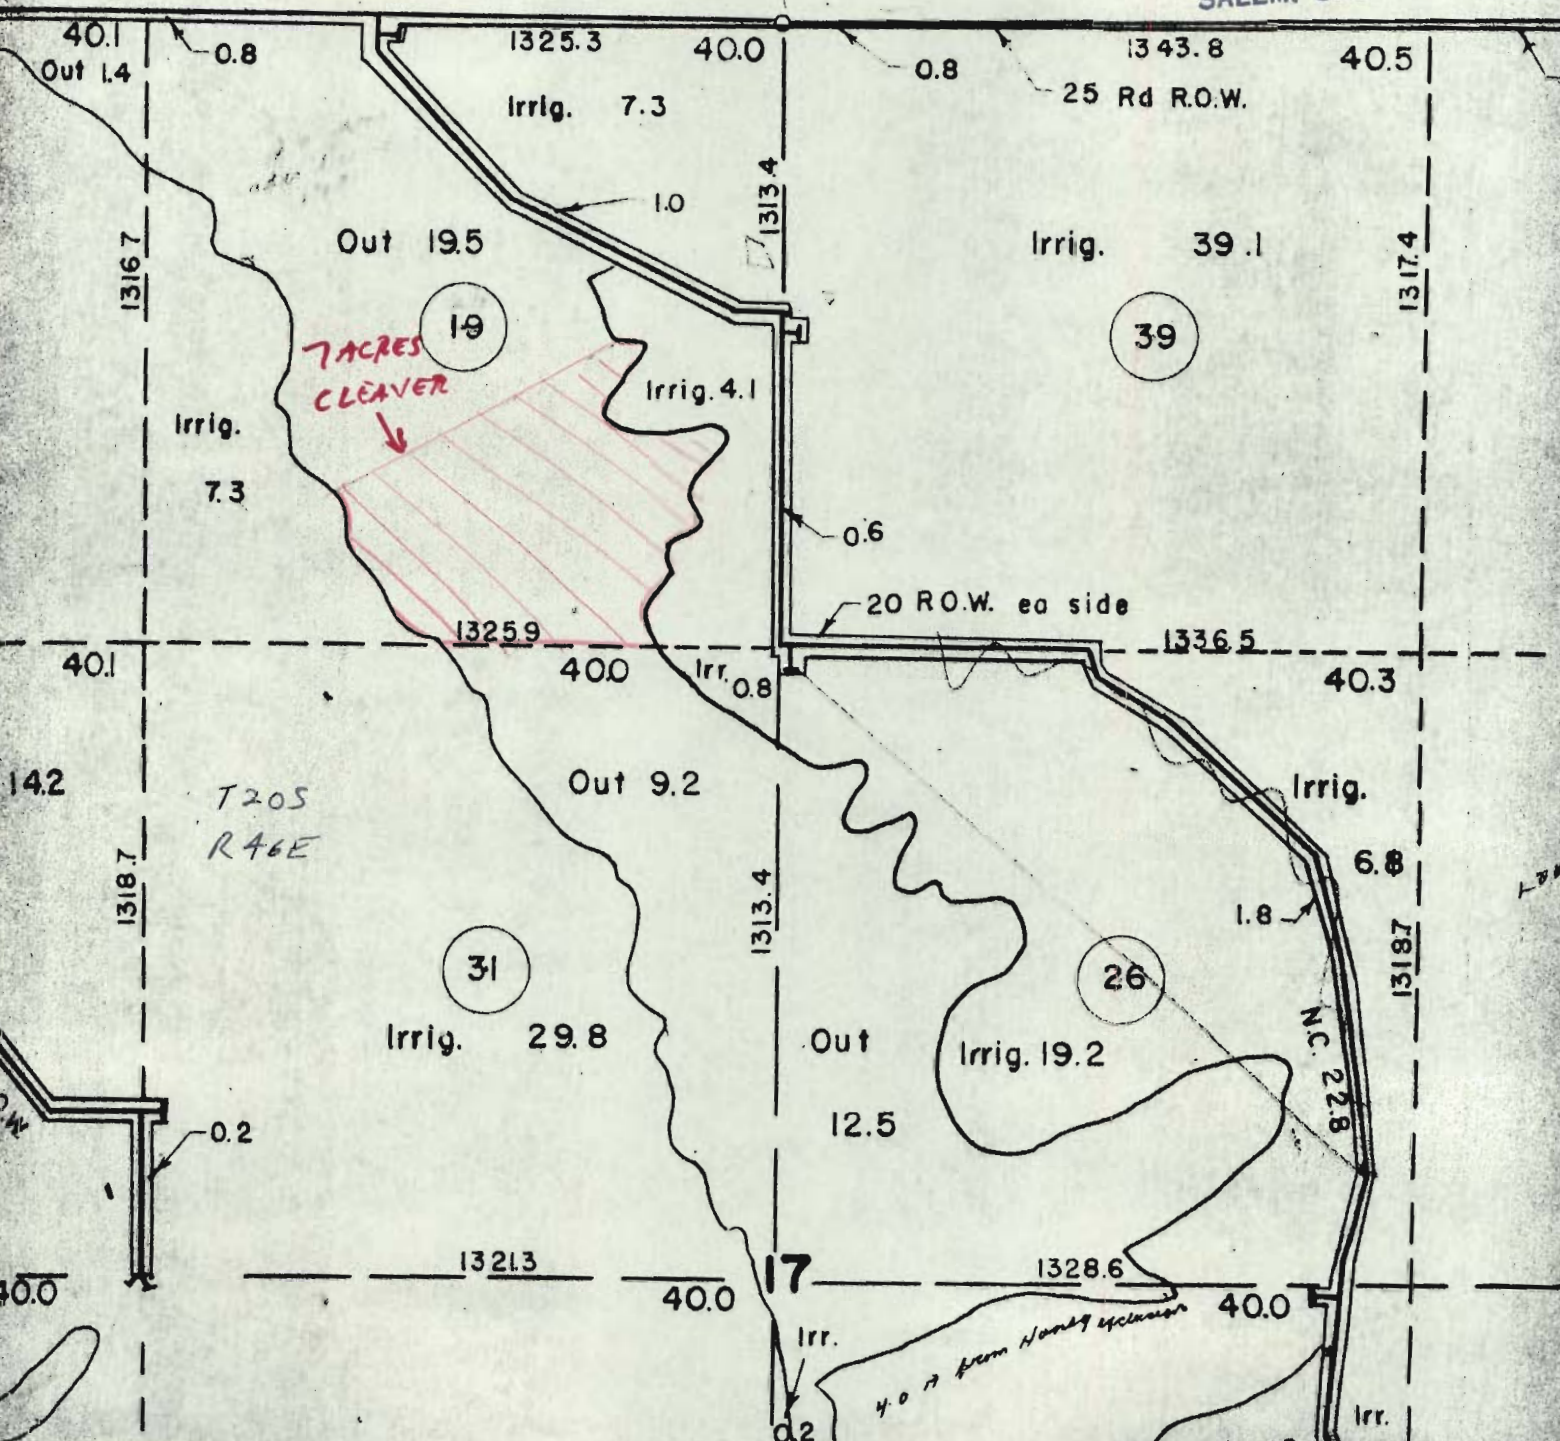

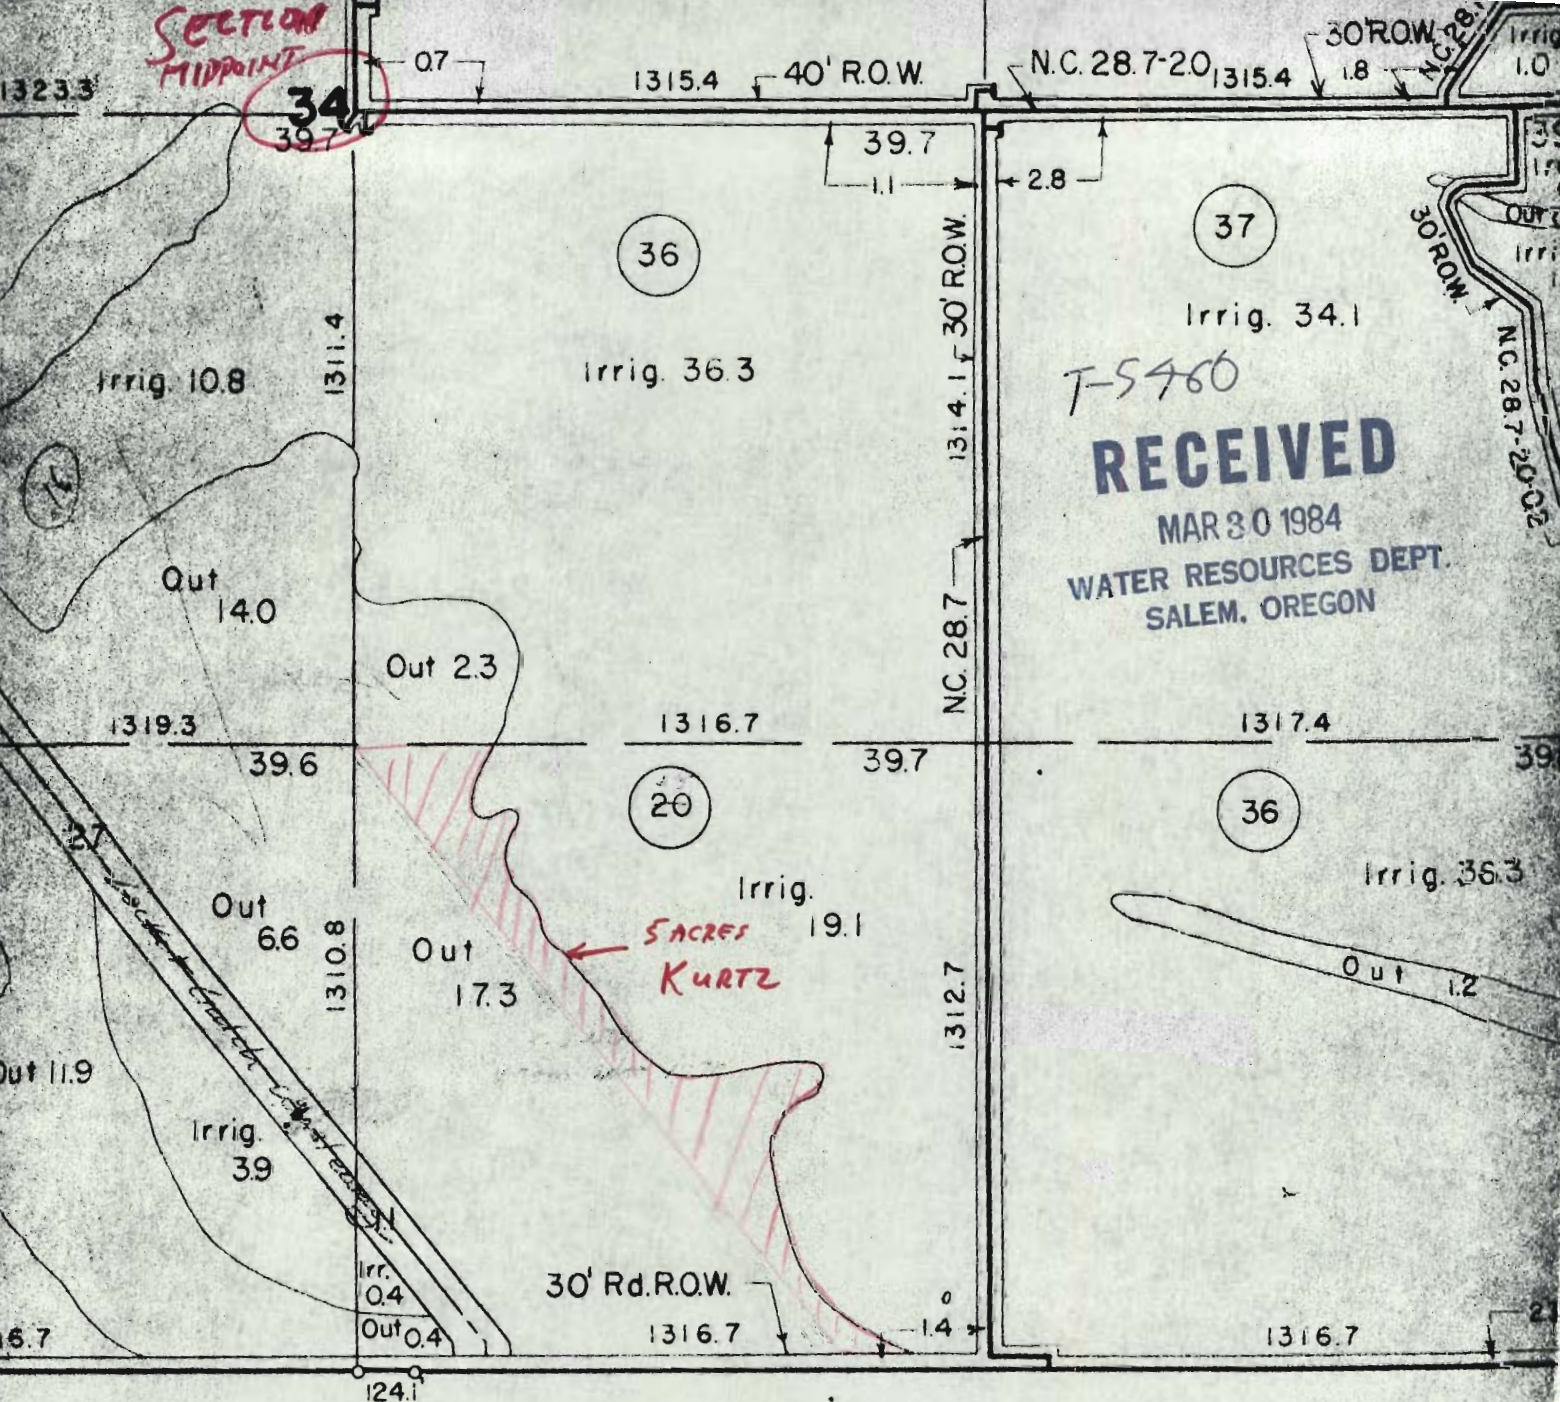


SEC. 34 - T. 19 S. - R. 46 E. - W. 1

MAR 30 1984

WATER RESOURCES DEPT
SALEM, OREGON

93'
50' *measured*

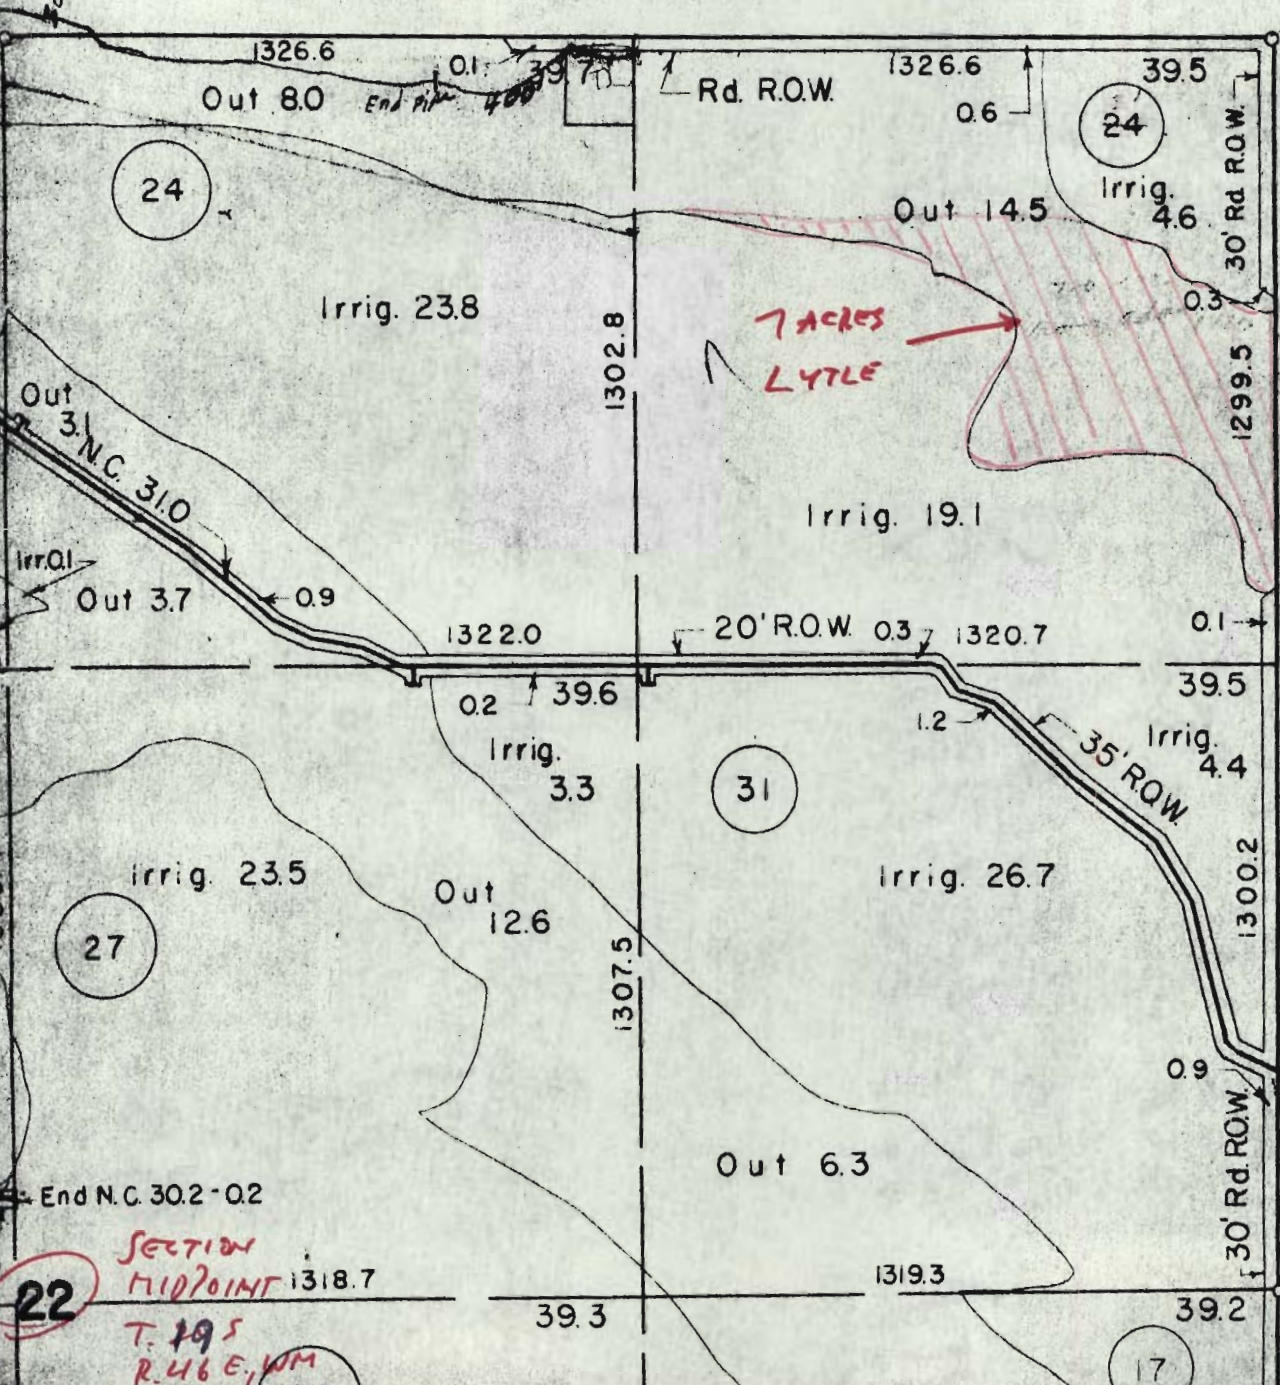

T-5460

SECTION
MIDPOINT
T. 19 S
R. 46 E, WM


22

17

RECEIVED

MAR 30 1984

WATER RESOURCES DEPT
SALEM, OREGON
25 Rd. R.O.W.

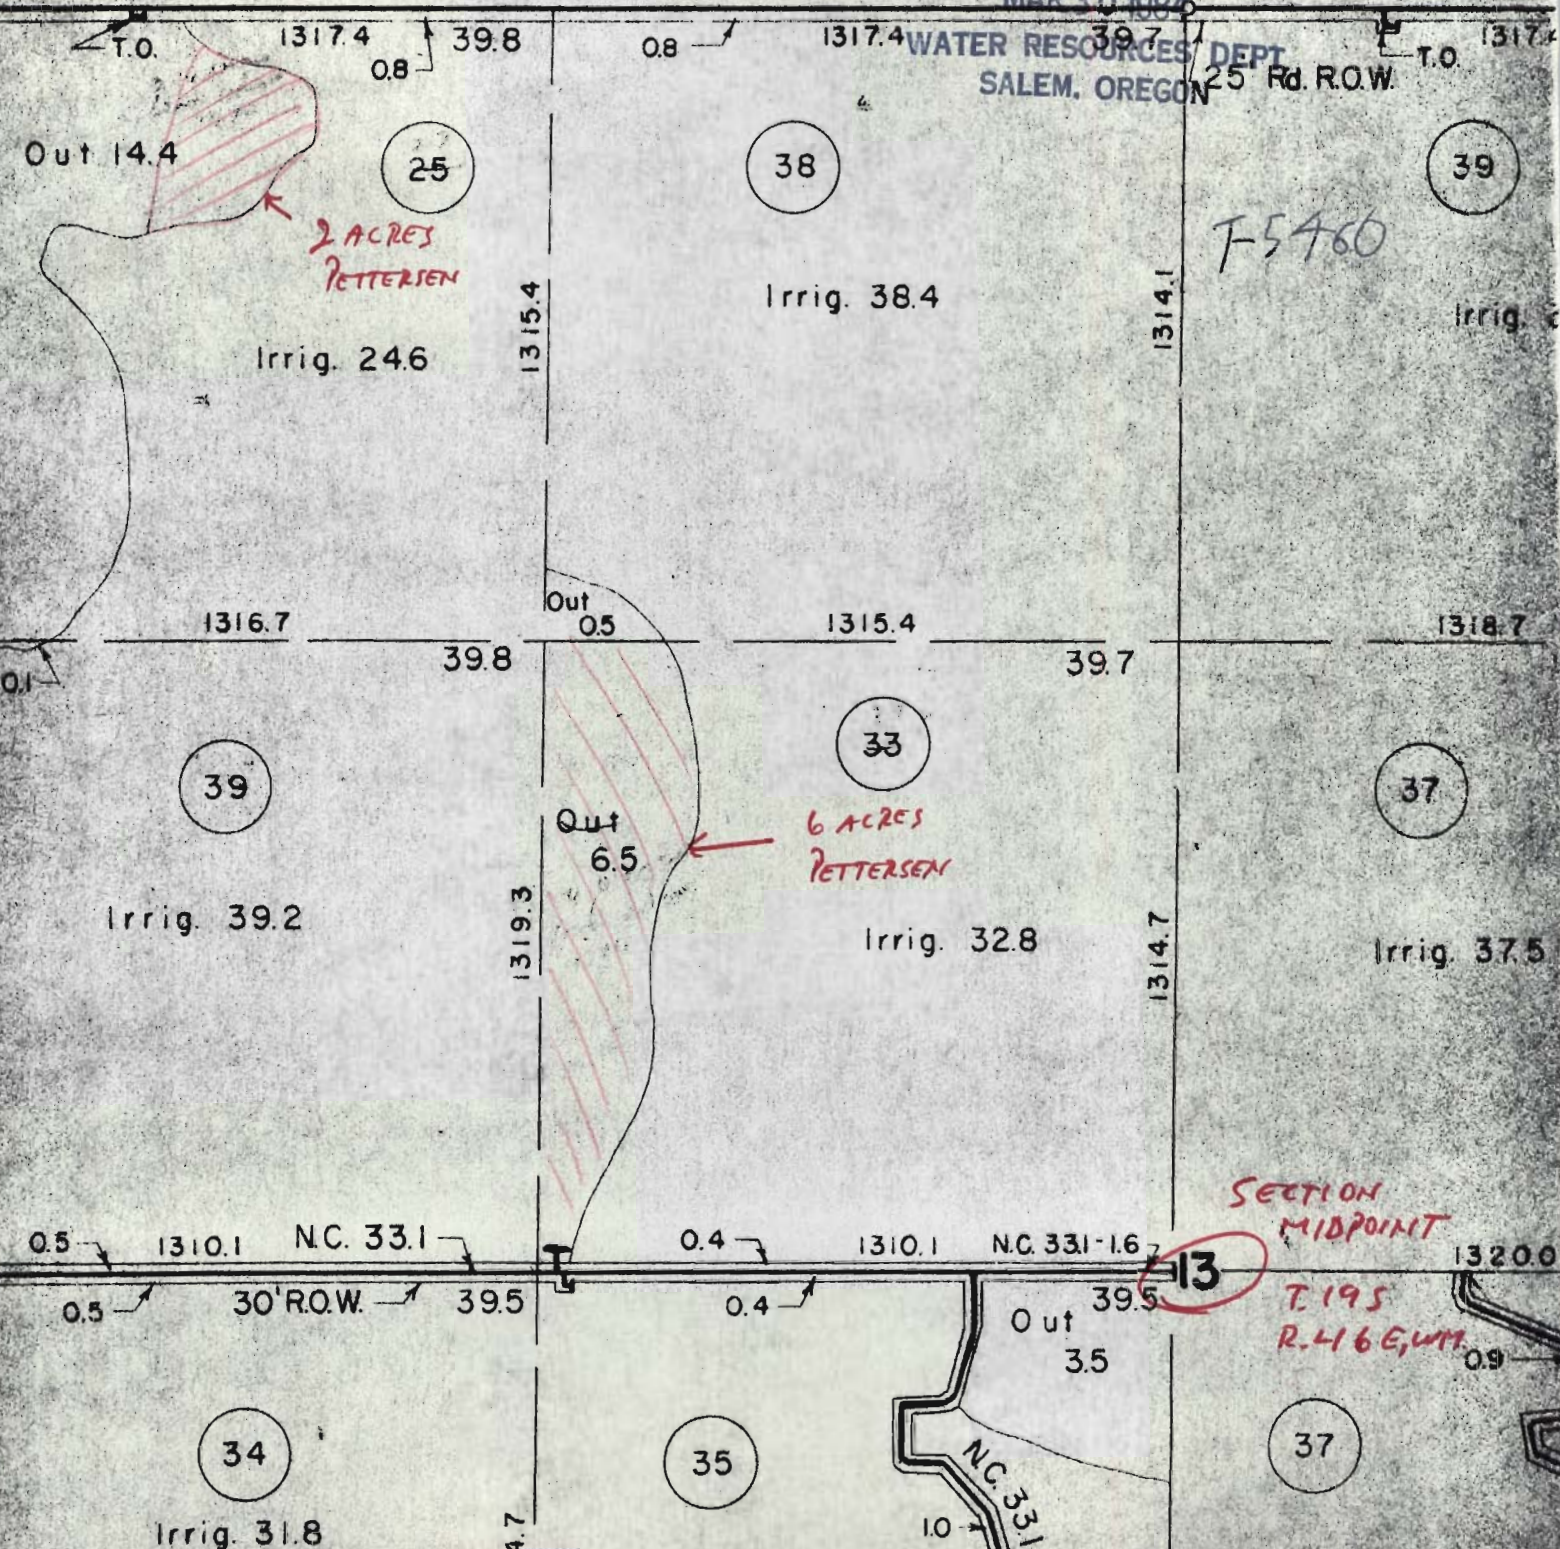


RECEIVED

MAR - 9 1987

WATER RESOURCES DEPT.
SALEM, OREGON

T-5460

INCLUSION MAP

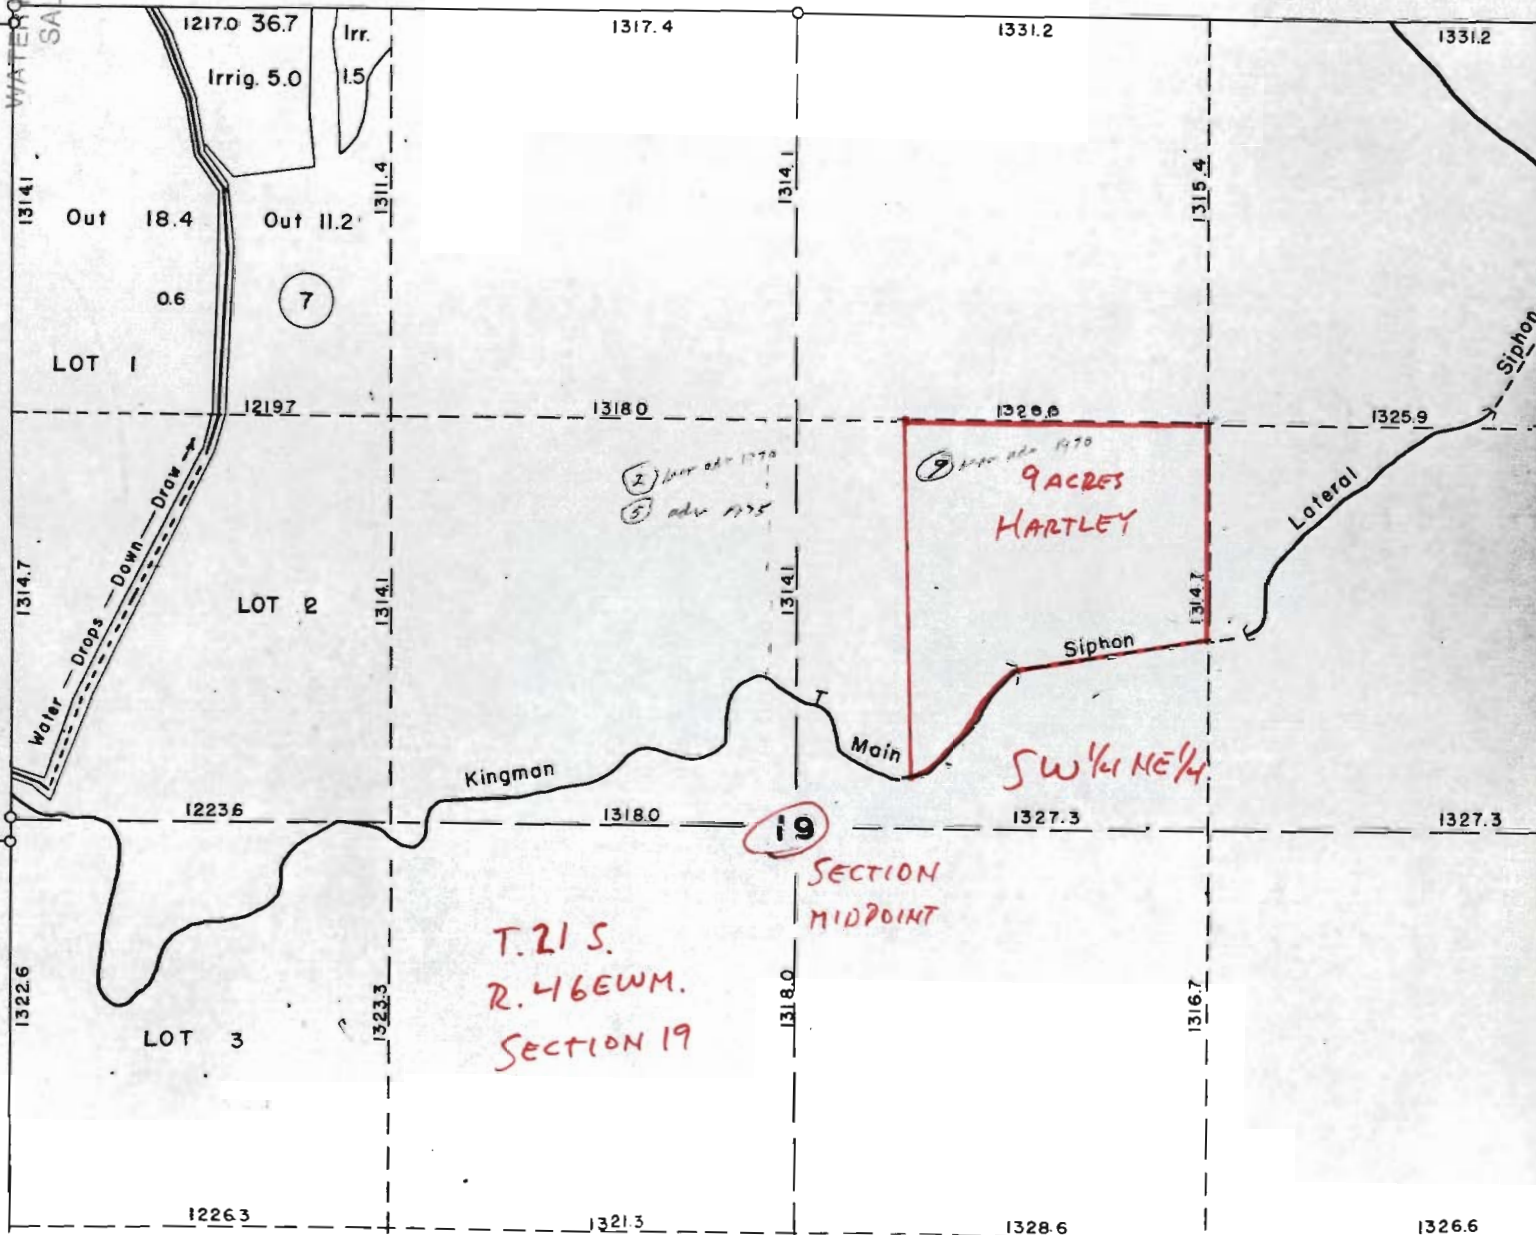

RECEIVED

MAR 30 1984

WATER RESOURCES DEPT.
SALEM, OREGON

T-5460

1317.4

1331.2

1331.2

1314.1

1315.4

1318.0

1328.6

1325.9

②

③


⑨

9 ACRES
HARTLEY

SEE MAP
RECEIVED
3-9-87

1314.1

1314.7

Siphon

Lateral

Siphon

19

SECTION
MIDPOINT

T. 21S
R. 46 E, WM


1318.0

1327.3

1327.3

1318.0


1316.7

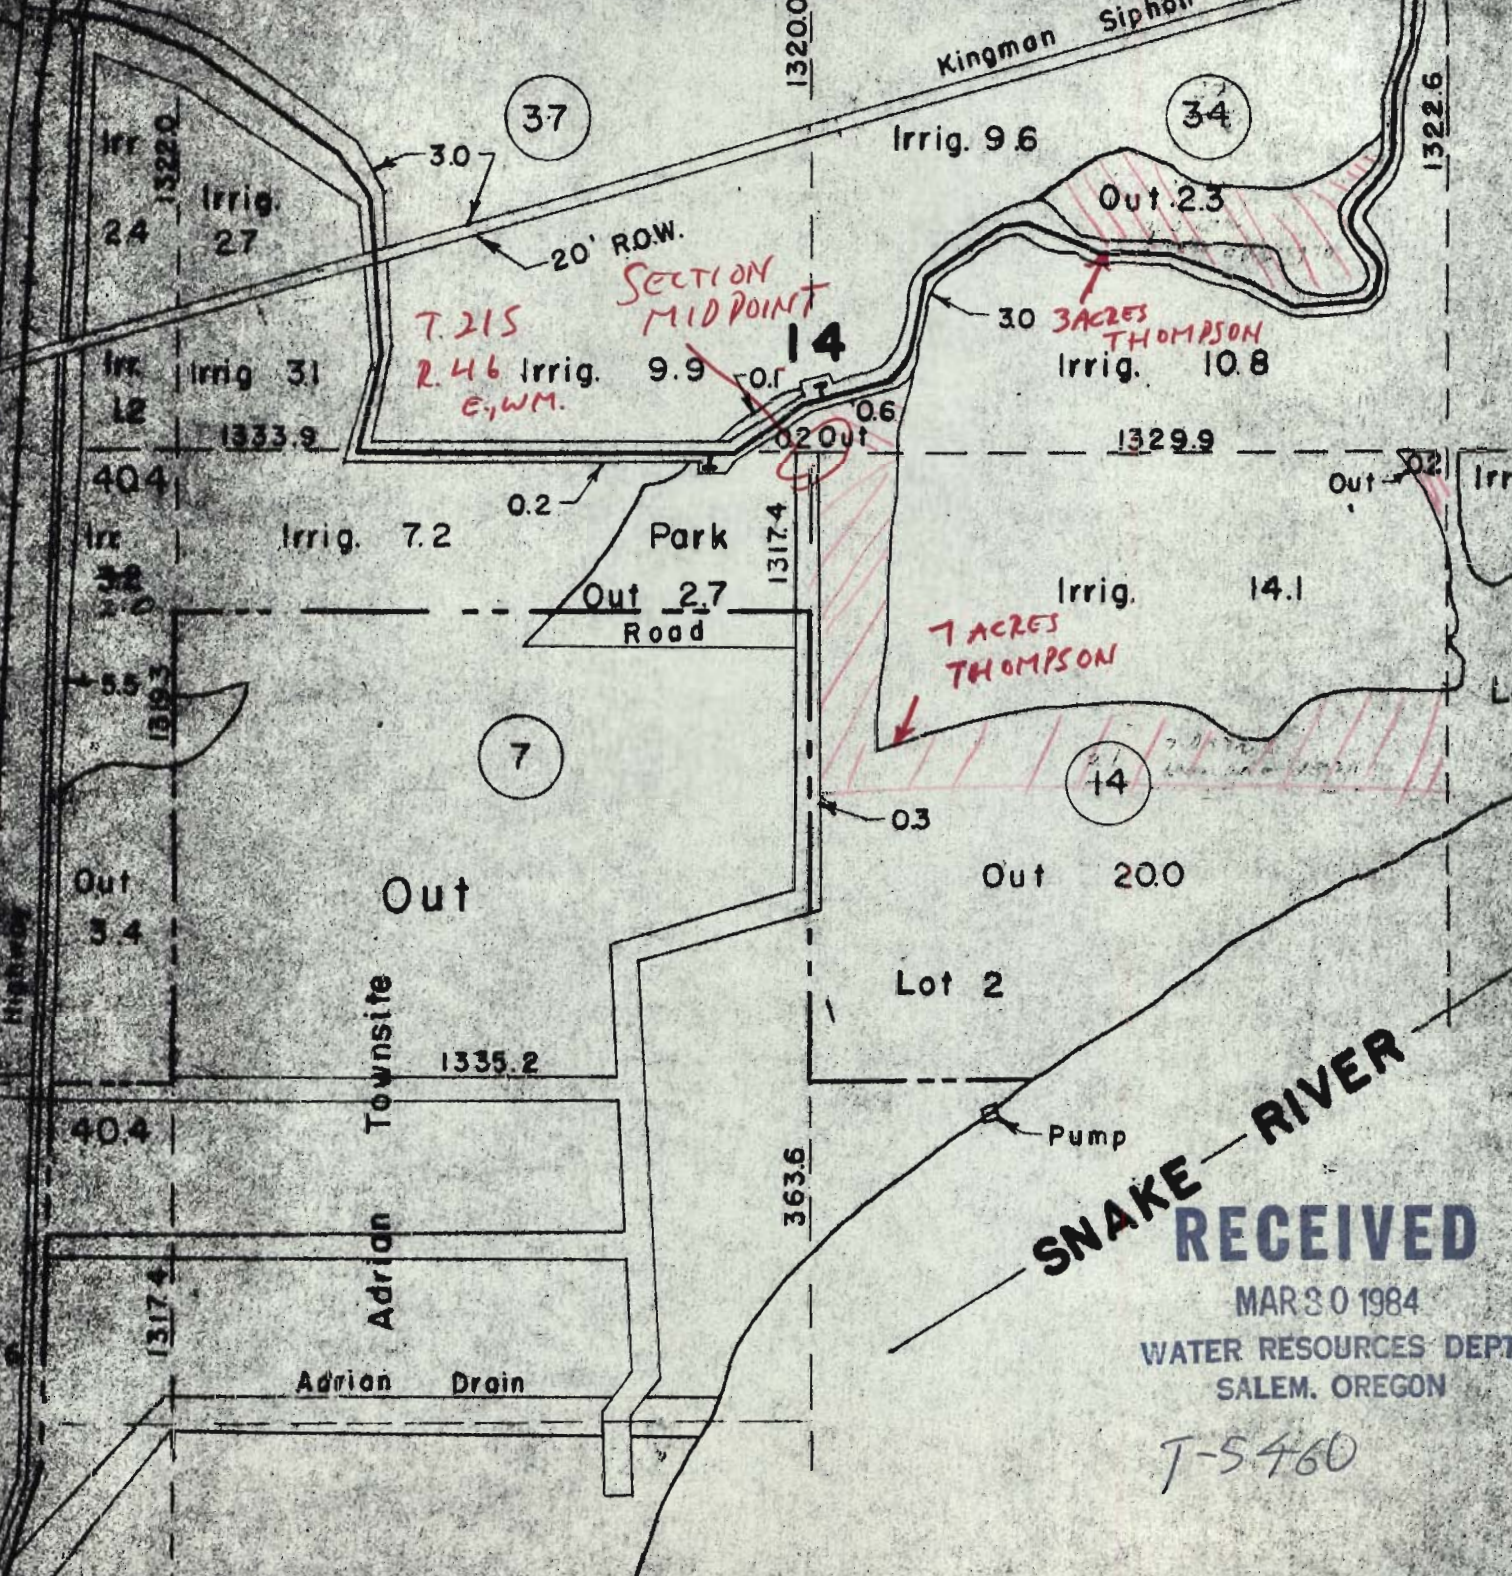

RECEIVED

MAR 30 1984
WATER RESOURCES DEPT
SALEM, OREGON

T-5460

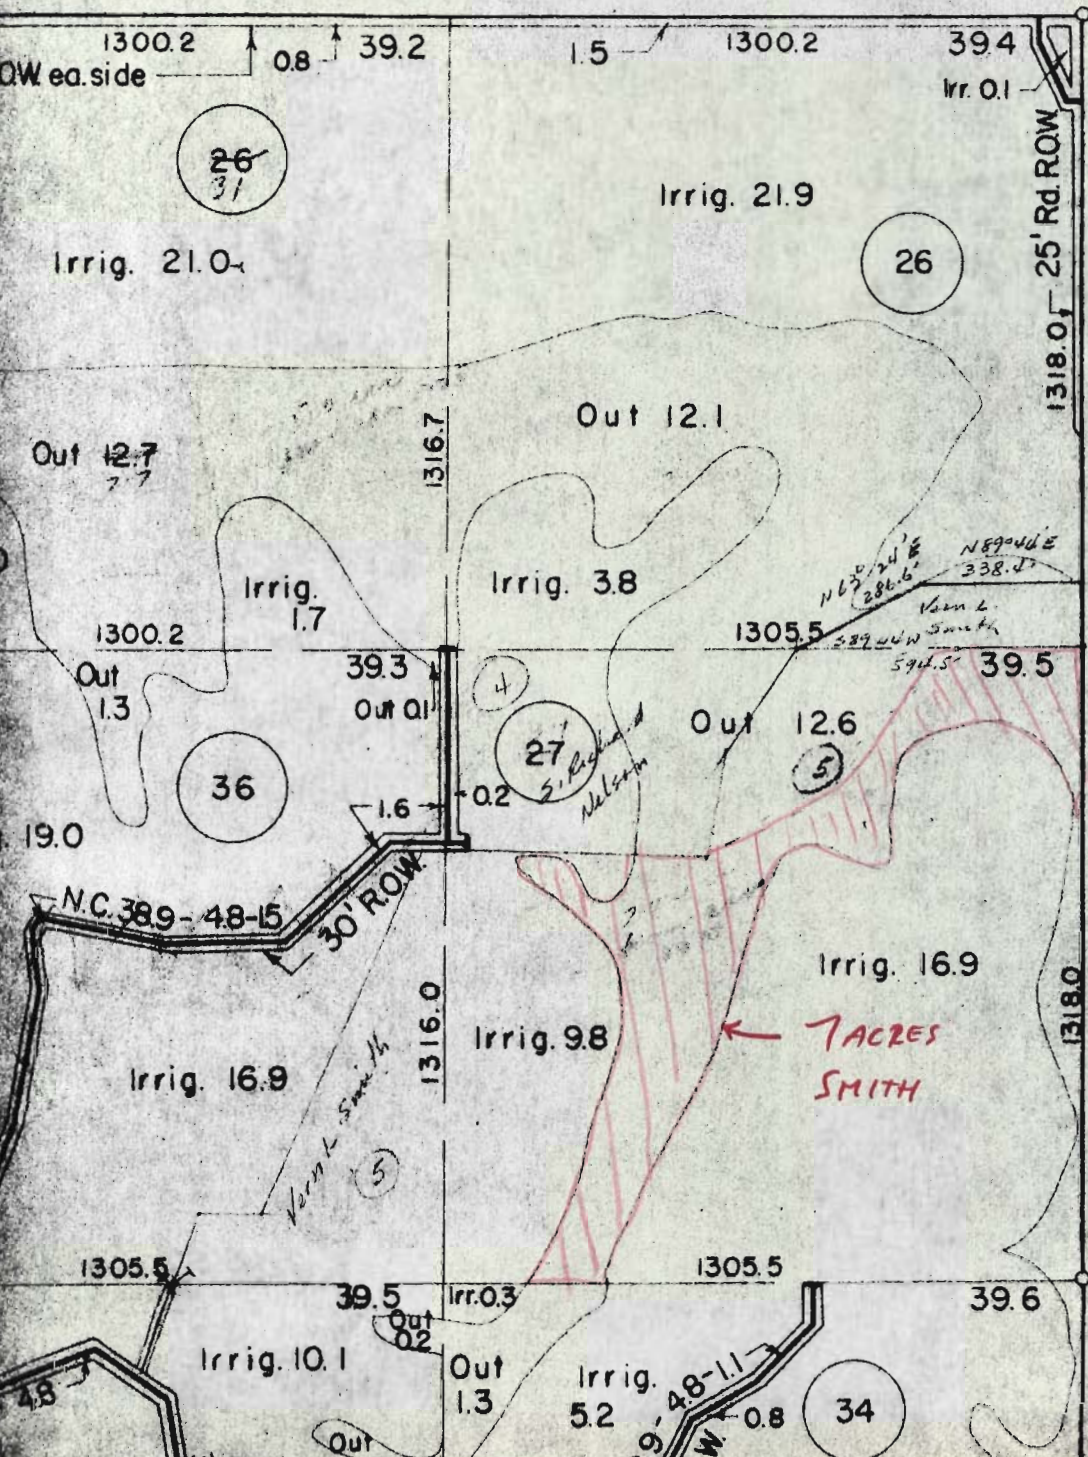

RECEIVED

MAR 30 1984
 WATER RESOURCES DEPT
 SALEM, OREGON

T-5460

SE 1/4 NE 1/4
 SECTION 28
 T. 18 S
 R. 46 E, WM.

RECEIVED

MAR 30 1984
WATER RESOURCES DEPT.
SALEM, OREGON

T-5460

