


T. 13S., R. 30E., W. M.

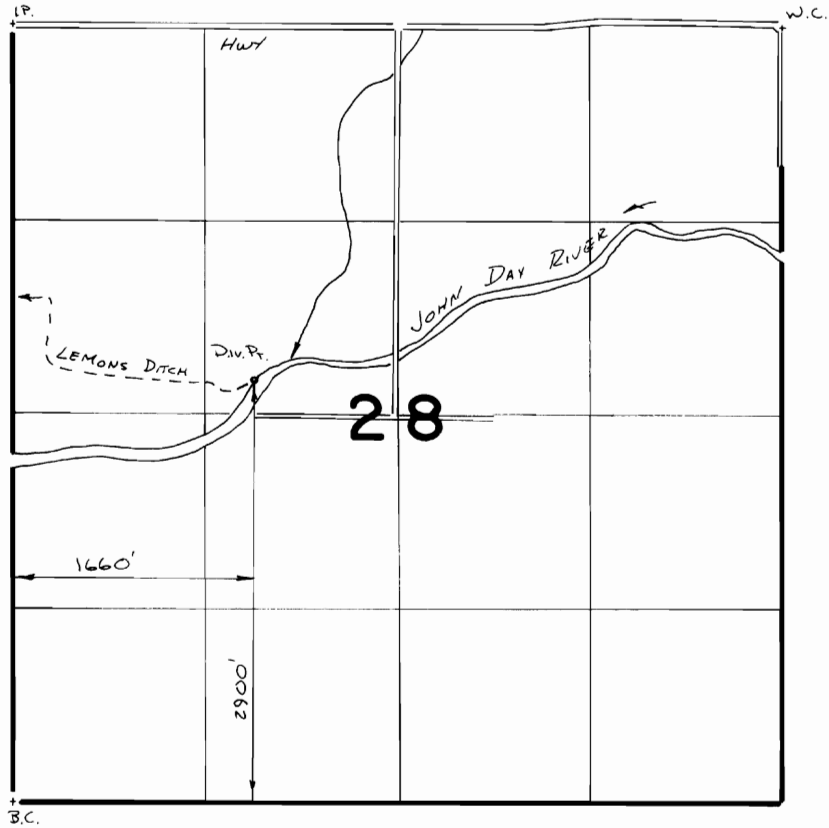

FINAL PROOF SURVEY
UNDER

TRANSFER 5461

IN NAME OF

JAMES A. MORRIS

Surveyed ..3-19..... 1986, by ..V.L. Church.....