



T.16S., R.11E., W.M.

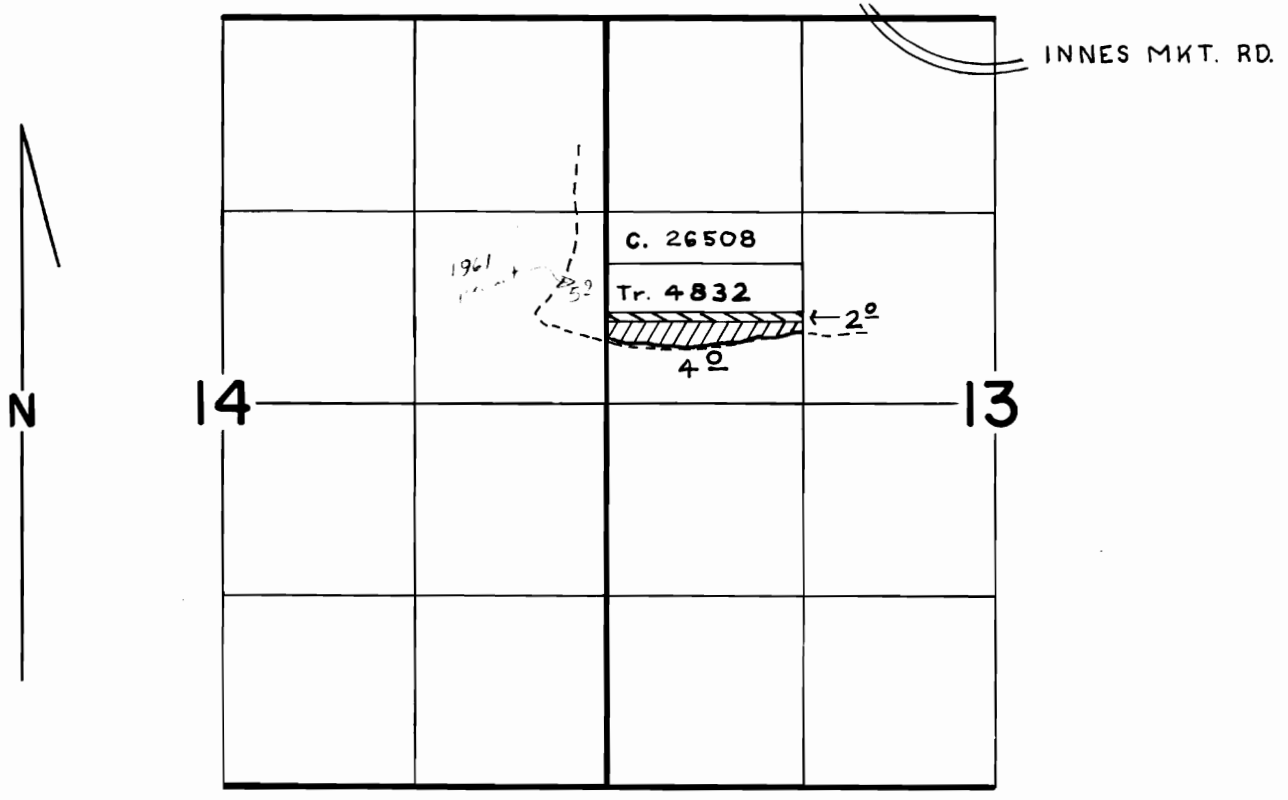

SCALE: 1" = 1320'

FINAL PROOF SURVEY

UNDER

TRANSFER NO. 5467 

AND PART OF TRANSFER NO. 5050  (2/2)

IN NAME OF

ROBERT E. GARDNER

Surveyed MAY. 25.. 1985., by LESLIE. OLSON...

T10
V. 36, p. 314
V. 38, p. 268