


T. 5N., R. 35E., W. M.

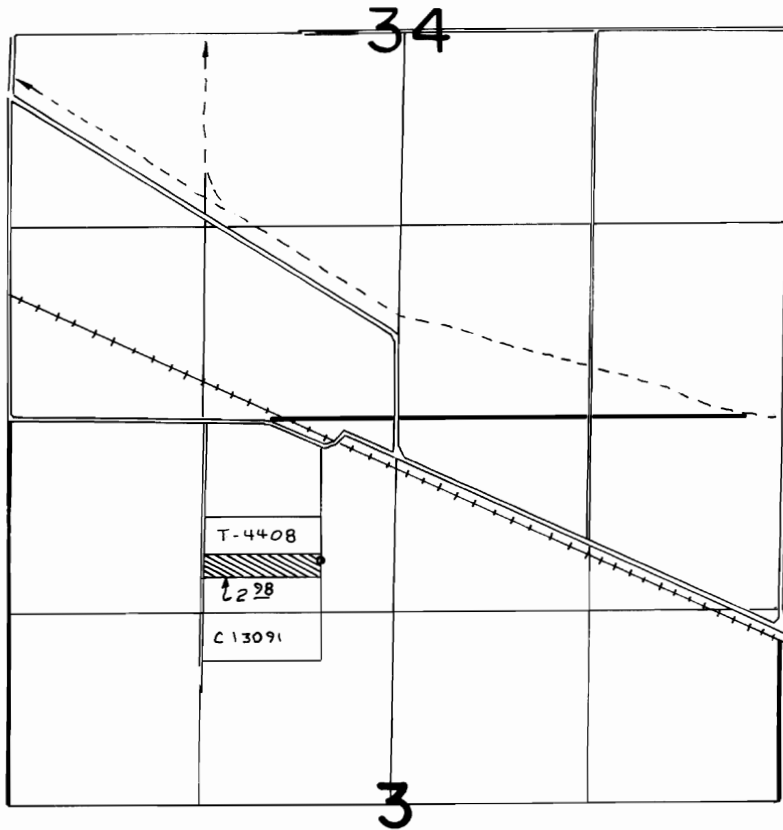

SCALE: 1" = 1320'

FINAL PROOF SURVEY
UNDER

TRANSFER 5471

IN NAME OF

LEE STEPHENS

Surveyed 10-24..... 1984., by V. L. Chutsh.....